

Well No. 1, Lesser Farm

Tyson Oil Company

N

Location -----

Drilling Remarks:

Rig Up -----

Drilling Remarks:

COMPLETED

Cased ----- in.-----ft.

Sand -----

Gas -----

Oil _____

Total Depth-----

1st 24 hrs. Nat.-----

1st 24 hrs. after shot-----

Gas ----- cu. ft.

Dry Hole -----

Abandoned -----

Map No. _____ Sec. 29 Twp. 23 R. 4


Well No. 1. Terrier Farm
Gypsy Oil Co. Company

200 Ft. from N. Line

_____Ft. from S. Line

1120 Ft. from E. Line

_____Ft. from W. Line

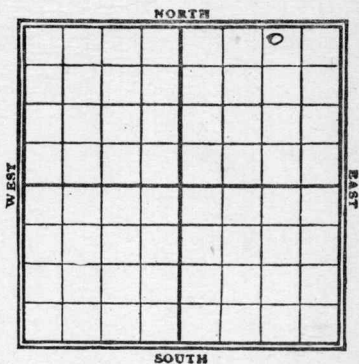

REPORT

Date 9

12/22 Linters.

1/4/30	Timber
--------	--------

6	Rig
---	-----

14	Spind.
----	--------

19	140'
----	------

27	Ar 800
----	--------

2/2	Del 1090'
-----	-----------

9 July. 1585'

16 - 2130'

23	Alg 2235'
----	-----------

31. Arch 2393-2405 (500' Circ in base)

8	2392'-2405'-Pump water rail
---	-----------------------------

15- 2393 - 2405 100 B00

Map No. K14 Sec. 29 Twp. 23 R. 4Well No. 1 FerrierGypsy Oil Company

Contractor

SECTION PLAT

200 Ft. from N. Line

Ft. from S. Line

1120 Ft. from E. Line

Ft. from W. Line

			0

Location

Rig up

Drilling and Remarks:

Timber

RECORD

Cased _____ in., _____ ft.

Sand _____

Gas _____

Oil _____

Total Depth _____

PRODUCTION

1st 24 hrs. Nat. _____

1st 24 hrs. after shot _____

Gas _____ Cu. Ft.

Dry Hole _____

Abandoned _____

Date

12/22 1919

Pyle

Scout

Map No. 514 Sec. 29 Twp. 23 R. 4Well No. 1 FerrisGypsy Oil Company

Contractor

SECTION PLAT

200 Ft. from N. Line

Ft. from S. Line

1120 Ft. from E. Line

Ft. from W. Line

			④

COMPLETED

Location

Rig up

Drilling and Remarks:

RECORD

Cased _____ in., _____ ft.

Sand 2393-2405

Gas _____

Oil _____

Total Depth _____

PRODUCTION

1st 24 hrs. Nat. 100 bbls

1st 24 hrs. after shot _____

Gas _____ Cu. Ft.

Dry Hole _____

Abandoned _____

Date

Pyle

3/15 1920

Scout