


KANSAS

Butler

Section 5 Township 26S Range 4E

Well No. #1 Hack

Company Rex & Morris

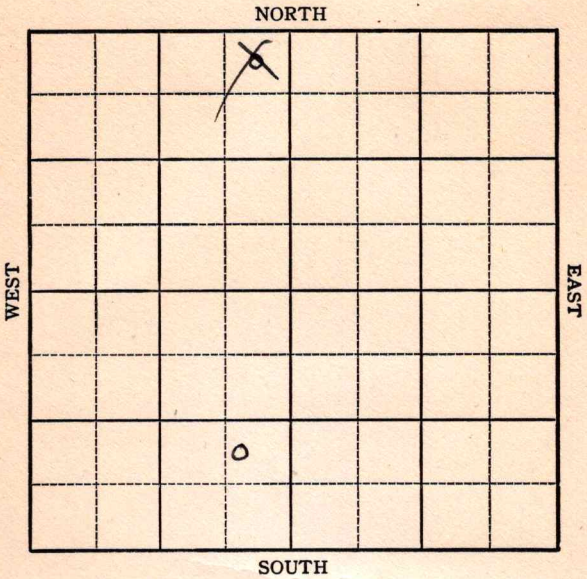

Sec. 5 Twp. 26 R. 4E

Well No. #1 Hack Farm

Rex & Morris

Company

Miscellaneous (Rex & Morris, Cont.)

NORTH

Ft. from N. Line

990'


Ft. from S. Line

550'

Ft. from E. Line

Ft. from W. Line

C N L SE SW

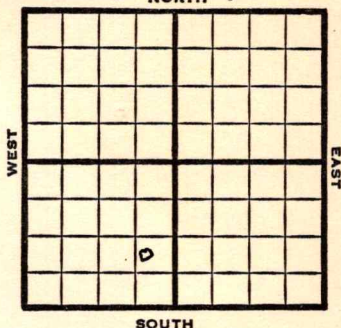

1949	Elev. 1263'	REPORT
9/14	Location	
9/21	20" @ 27'	
	Drlg. 120'	
9/28	12" @ 840'	
	Drlg 1140'	
10/5	Drlg 1795'	
10/12	10" @ 1650'	
	8" @ 2285'	
	Drlg 2310'	
10/19	Lansing 1775'	
	KC 2145'	
	Mississippi 2665'	
	Drlg 2825'	
10/26	Miss 2665'	
	TD 2890 in Miss	
	ABANDONED	

Map No. _____ Sec. 5 Twp. 26 R. 4E


Well No. 1 Hack

Rex & Morris Company

Rex & Morris Contractor

C N L SE SW

SECTION PLAT

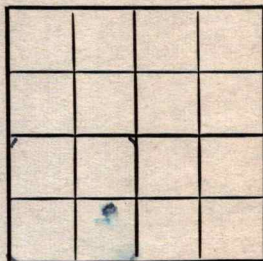

_____ Ft. from N. Line

990 Ft. from S. Line

550 Ft. from E. Line

_____ Ft. from W. Line

Butler County

RECORD

Location X

Cased _____ in., _____ ft.

Rig up _____

Sand _____

Drilling and Remarks:

Gas _____

Oil _____

Total Depth _____

PRODUCTION

1st 24 hrs. Nat. _____

1st 24 hrs. after shot _____

Gas _____ Cu. Ft.

Dry Hole _____

Abandoned _____

Date .

SEP 14 1949

19

S. J. LEWIS

Scout

Kansas

Map No. _____ Sec. 5 Twp. 26 R. 4EWell No. 1 Hack

Rex & Morris _____ Company

ABANDONED _____ Contractor

C N L SE SW

E11263
SECTION PLAT

	4		

_____ Ft. from N. Line

990 Ft. from S. Line550 Ft. from E. Line

_____ Ft. from W. Line

Butler County

Location _____

Rig up _____

Drilling and Remarks:

*Min 2665'***RECORD**

Cased _____ in., _____ ft.

Sand _____

Gas _____

Oil _____

Total Depth 2890 in Min**PRODUCTION**

1st 24 hrs. Nat. _____

1st 24 hrs. after shot _____

Gas _____ Cu. Ft.

Dry Hole _____

Abandoned _____

Date

OCT 26 1949

19

S. J. LEWIS

Scout