


Map No. 8-29 Sec. 23 Twp. 23 R. 4E

Well No. Phillips Pit Farm _____ Company _____

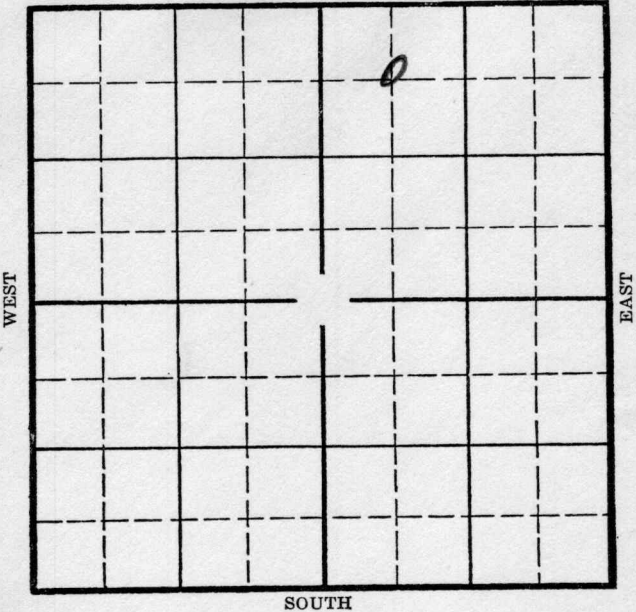

Location _____
Drilling Remarks _____

Rig Up _____
Drilling Remarks _____

RECORD

Cased _____ in. _____ ft.
Sand _____
Gas _____
Oil _____
Total Depth _____

PRODUCTION

1st 24 hrs. Nat. _____
1st 24 hrs. after shot _____
Gas _____ cu. ft. _____
Dry Hole _____
Abandoned _____

Butler

Map No. Sec. 29 Twp. 23 R. 4E

Well No. 8-Neer Farm
Phillips Pet. Company


660 Ft. from N. Line

 Ft. from S. Line

 Ft. from E. Line

660 Ft. from W. Line

Elev. 1353

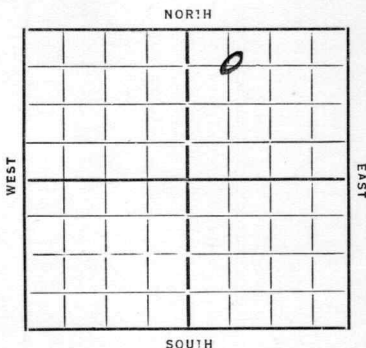

Date 1985 REPORT

9/4 Rgn Mch.
10/3 AO 2008-14 8" 2000
10/10 AO 2080-86 TD 2104
PB 2088 1000 acid
10/30 KCL 1975
TD 2104
PB 2088
1000 acid
25 oil
10 wtr.

COMPLETED

Butler
 Map No. 14 Sec. 29 Twp. 23 R. 4 E

Well No. 8-Weer

Phillips pet Company

Contractor

FIRST REPORTS

SECTION PLAT

		0	

660 Ft. from N. Line

..... Ft. from S. Line

..... Ft. from E. Line

660 Ft. from W. Line

Location.....

Rig up.....

Drilling and Remarks:

RECORD

Cased.....in., ...ft.

Sand.....

Gas.....

Oil.....

Total Depth.....

PRODUCTION

1st 24 hrs. Nat.....

1st 24 hrs. after shot.....

Gas.....Cu. Ft.

Dry Hole.....

Abandoned.....

Date

9-4-35 192..... Scout

ORVAL MANNSCHRECK

KANSAS

Map No. 14 Sec. 29 Twp. 23 R. 4E

Well No. 8 - near

Phillips pit

Company

Contractor

COMPLETED

SECTION PLAT

660 Ft. from N. Line

..... Ft. from S. Line

..... Ft. from E. Line

660 Ft. from W. Line

		0	

Location.....

Rig up.....

Drilling and Remarks:

PB 2088

1000 Acid

25 oil
10 water

RECORD

Cased..... in., ... ft.

Sand KEL 1975

Gas.....

Oil.....

Total Depth 2104

PRODUCTION

1st 24 hrs. Nat.....

1st 24 hrs. after shot.....

Gas..... Cu. Ft.

Dry Hole.....

Abandoned.....

Date

10-30-35 192.....

ORVAL MANNSCHRECK

Scout