


NORTH

WEST

EAST

SOUTH

Location\_\_\_\_\_

### Drilling Remarks

Rig Up.....

### Drilling Remarks

RECORD

Cased.....in.....ft.

Sand.....

Gas \_\_\_\_\_

Oil.....

Total Depth.....

## PRODUCTION

1st 24 hrs. Nat. ....

1st 24 hrs. after shot\_\_\_\_\_

Gas. \_\_\_\_\_ cu. ft.

Dry Hole.....

Abandoned.....


Map No. **KANSAS** Sec. 15 Twp. 23 R. 13  
Well No. 15 - Schneider Farm  
Shaffer & Howell Company

200 Ft. from N. Line

\_\_\_\_\_ Ft. from S. Line

660 Ft. from E. Line

\_\_\_\_\_ Ft. from W. Line

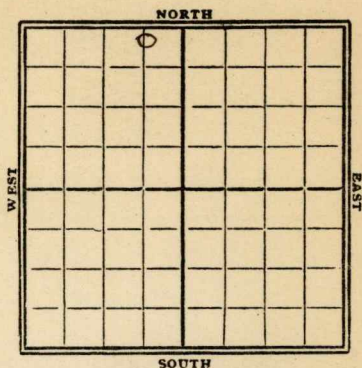

1929

Date

REPORT

| Date | REPORT          |
|------|-----------------|
| 7/2  | Spdy            |
| 7/10 | Drilg 450'      |
| 7/17 | " 1000'         |
| 7/24 | " 1390'         |
| 7/31 | Top line 1775'  |
|      | sand 1785-1811' |
|      | T.D. 1823       |
|      | 10 bbl oil      |
|      | Sump.           |

Map No. **KANSAS** Sec. 15 Twp. 23 R. 13

Well No. 15 Schneider

Shaffer & Howell Company

Contractor

# **FIRST REPORTS**

## **SECTION PLAT**

|  |   |  |  |
|--|---|--|--|
|  | 0 |  |  |
|  |   |  |  |
|  |   |  |  |
|  |   |  |  |

200 Ft. from N. Line

\_\_\_\_\_ Ft. from S. Line

660 Ft. from E. Line

\_\_\_\_\_ Ft. from W. Line

Location Spdy

Rig up \_\_\_\_\_

Drilling and Remarks:

## **RECORD**

Cased \_\_\_\_\_ in., \_\_\_\_\_ ft.

Sand \_\_\_\_\_

Gas \_\_\_\_\_

Oil \_\_\_\_\_

Total Depth \_\_\_\_\_

## **PRODUCTION**

1st 24 hrs. Nat. \_\_\_\_\_

1st 24 hrs. after shot \_\_\_\_\_

Gas \_\_\_\_\_ Cu. Ft.

Dry Hole \_\_\_\_\_

Abandoned \_\_\_\_\_

Date

7/2

1929

**CHAS. L. SHERWOOD**

Scout

Sherwood

K87 **KANSAS** Map No. Sec. 15 Twp. 23 R. 13

Well No. 15 Schneider

Shaffer &amp; Hewell Company

Contractor

**COMPLETE****SECTION PLAT**

|  |   |  |  |
|--|---|--|--|
|  | 0 |  |  |
|  |   |  |  |
|  |   |  |  |
|  |   |  |  |

200 Ft. from N. Line

Ft. from S. Line

660 Ft. from E. Line

Ft. from W. Line

Location

Rig up

Drilling and Remarks:

top line 1775'

10 Bls.

**RECORD**

Cased in., ft.

Sand 1785-1811

Gas

Oil

Total Depth 1823

**PRODUCTION**

1st 24 hrs. Nat.

1st 24 hrs. after shot

Gas Cu. Ft.

Dry Hole

Abandoned

Date

JUL 31 1929

**CHAS. L. SHERWOOD**

19

Scout