KANSAS

FORM 51 10M 7-48 PETROL


Butler

Section 5 Township 26 Range 4E

Well No. 5 Rice

Company Rex & Morris et al

Misc.

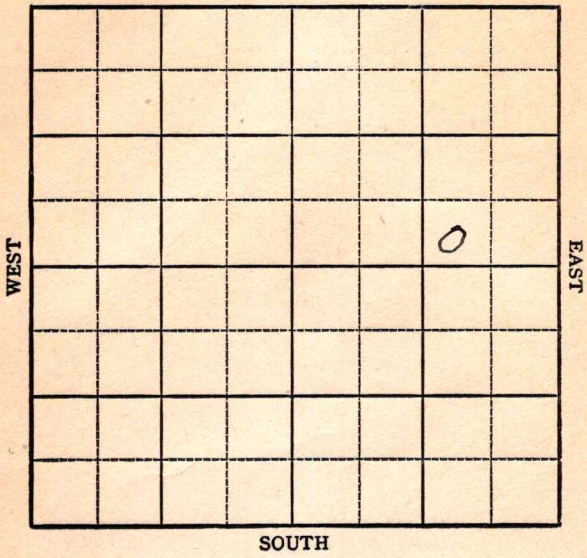

FORM 252-A
5M 10-48 PETROL


KANSAS Butler ✓

Sec. 5 Twp. 26 R. 4-E

Well No. #5 Rice Farm

Rex & Morris etal Company

Miscellaneous

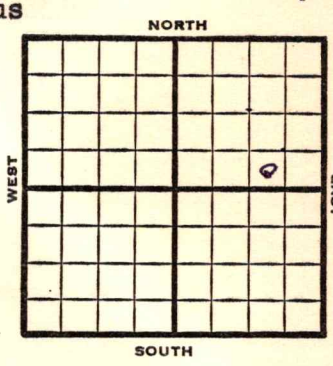

_____ Ft. from N. Line

330 Ft. from S. Line

990 Ft. from E. Line

_____ Ft. from W. Line

SW SE NE

1948	REPORT
	Eli 1311'
9/29	Machine
10/6	Spud
10/13	13" @ 890' Drlg. 1070'
10/19	Drlg. 1705' 10" @ 1680'
10/26	Lansing 1762' KC 2062' 8" @ 2290 Drlg. 2432'
11/3	TD 2449' 7"@ 2435'
11/10	TD 2449' Miss 2290' Simp 2435' 7"@ 2435' Pump 50 oil Pot 38° Gr. Comp COMPLETED

Form 26—200 Bks.—1-48—Palace

Miscellaneous

Kansas

Map No. _____ Sec. 5 Twp. 26 R. 4E


Well No. 5 Rice

Rex & Morris etal. Company

FIRST REPORT Contractor

SW SE NE

SECTION PLAT

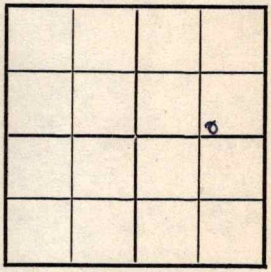

_____ Ft. from N. Line

330 Ft. from S. Line

990 Ft. from E. Line

_____ Ft. from W. Line

Butler County

Location _____

Rig up _____

Drilling and Remarks:

Machine

RECORD

Cased _____ in., _____ ft.

Sand _____

Gas _____

Oil _____

Total Depth _____

PRODUCTION

1st 24 hrs. Nat. _____

1st 24 hrs. after shot _____

Gas _____ Cu. Ft.

Dry Hole _____

Abandoned _____

Date

SEP 29 1948 19____ S. J. LEWIS Scout

Form 26 200 Bks. 9-48 Petrol

Kansas

Miscellaneous

Map No. 4 Sec. 5 Twp. 26 R. 4E

Well No. 5 Rice


Rex & Morris etal. Company

COMPLETE Contractor

SW SE NE

E.1.B.H.

SECTION PLAT

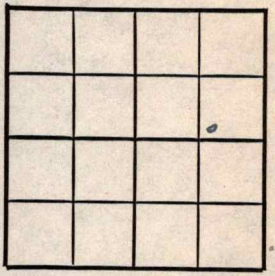

Ft. from N. Line

330 Ft. from S. Line

990 Ft. from E. Line

Ft. from W. Line

Butler County

Location

Rig up

Drilling and Remarks:

Wich 2290
Sing 2435-
T.D. 2445
Pump 50 oil 8H

98 Gr

RECORD

Cased in., ft.

Sand

Gas

Oil ✓

Total Depth 2449

PRODUCTION

1st 24 hrs. Nat.

1st 24 hrs. after shot

Gas Cu. Ft.

Dry Hole

Abandoned

Date

NOV 10 1948 19

S. J. LEWIS Scout