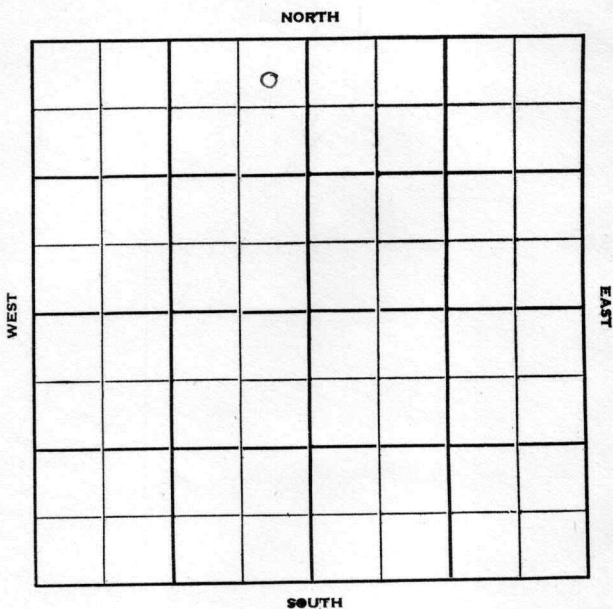


Section 30 Township 23 Range 4EWell No. #1 ScrivinerCompany Rex & Morris

Butler

KANSAS

Sec. 30 Twp. 23 R. 4E

Well No. #1 Schriviner Farm

Rex & Morris Company

Contractor

Semi Wildcat


330 Ft. from N. Line

Ft. from S. Line

330 Ft. from E. Line

Ft. from W. Line

NE NE NW

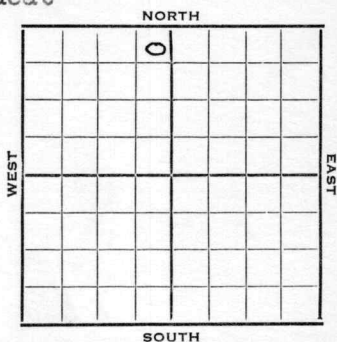

1952 Elev. 1425' REPORT

2/27 Location

3/26 Spud 3-8-52

D & A TD 2548'

8" @ 122 Lans. 1815' KC 2120'

Cong. 2381' Miss 2405' 5" @ 2405'

B. Miss 2435' Hunton 2527'

TD 2548' HFW

D & A

ABANDONED

County **Butler** State **Kansas**Sec. **30** (Blk.) **23** (Sur.) **4E** Map No.Operator **Rex & Morris**Well No. **1** Farm **Scriviner**Elev. Location **NE NE NW**

FIRST REPORT

330 Ft. From **N** Line **NW****330** Ft. From **E** Line Quarter1st. Report **FEB 27 1952**

Completion

Remarks

Spudding Date

Drlg. Data **Semi Wildcat****Location****J. G. McGEHEE**

County Butler State Kansas
 Sec. 30 (Blk. 23) (Sur. 4E) Map No.

Operator Rex & Morris

Well No. 1 Farm Scriviner

Elev. 1425 Location NE NE NW



330 Ft. From N Line NW

330 Ft. From E Line Quarter

1st. Report

Completion MAR 26 1952

Remarks Semi Wildcat

Spudding Date 3-8-52

Drilg. Data D & A TD 2548

8" @ 122 Lans. 1815 KC 2120

Cong. 2381 Miss. 2405 5" @ 2405

B. Miss. 2435 Hunton 2527 TD 2548

HFW

D & A

J. G. McGEHEE