
Form 51—5-19—5M—Mid-West

Map No. K 14 Sec. 17 Twp. 23 R. 4

Well No. 5 Lathrop Farm

National Ref. Company

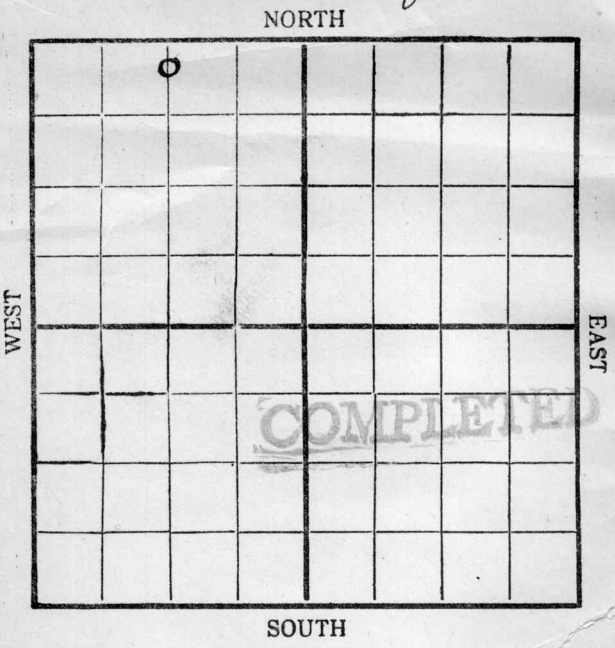

Location _____

Drilling Remarks:

Rig Up _____

Drilling Remarks:

RECORD

Cased _____ in. _____ ft.

Sand _____

Gas _____

Oil _____

Total Depth _____

PRODUCTION

1st 24 hrs. Nat. _____

1st 24 hrs. after shot _____

Gas _____ cu. ft.

Dry Hole _____

Abandoned _____

Form 252A 2M-9-19-CroMac.


Map No. _____ Sec. 17 Twp. 23 R. 4

Well No. 5 Sathrop Farm

National O. & R. Co Company

_____ Contractor

NW. Quarter

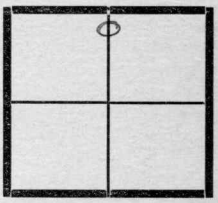

700 Ft. from N. Lice

_____ Ft. from S. Line

_____ Ft. from E. Line

1320 Ft. from W. Line

Date	REPORT
10/11	Drlg. 675'
10/21	Drlg. 810'
10/31	" 1100'
11/4	Drl 1445
12	Drl 1810
19	Drl 1875
25	Drlg. 2229'
12/2	Drlg 2350
9	Set 5 3/16" - 2391'
16	Drl 2391'
23	Sand 2381-91'- So Bee


COMPLETED COMPLETED COMPLETED

Form T-135 2-28-18 1m. Books, 50 Sets to Book

Map No. K 14 Sec. 17 Twp. 23 R. 4

Well No. 5 Lathrop Farm

National Ref Company

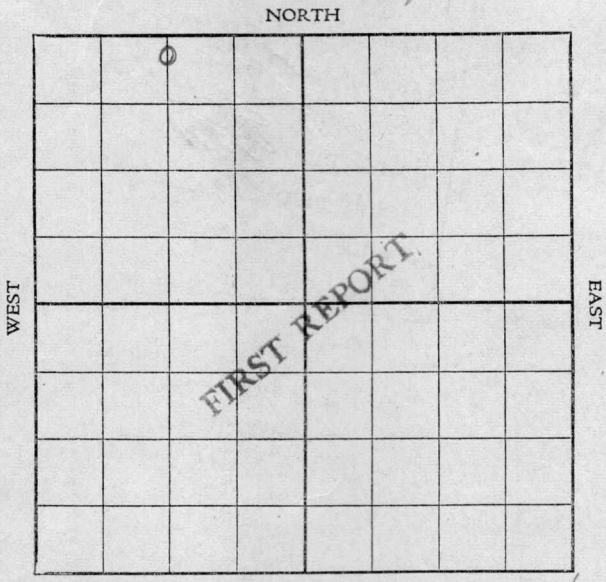

1320 W 200 N

Location

Rig up

Drilling and Remarks:

Junibers

RECORD

Cased in. Ft.

Sand

Gas

Oil

Total Depth

PRODUCTION

1st 24 hrs. Nat.

1st 24 hrs. after shot

Gas Cu. Ft.

Dry Hole

Abandoned

Date

8/25, 1919, Cyle Scout

Form 26—1M—4-19—Mid-West


Map No. 1514 Sec. 17 Twp. 23 R. 4

Well No. 5 Lathrop

National Ref. Company

Contractor

SECTION PLAT

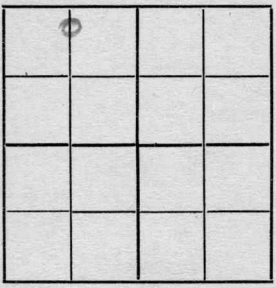

200 Ft. from N. Line

Ft. from S. Line

Ft. from E. Line

1320 Ft. from W. Line

Location

Rig up ✓

Drilling and Remarks:

RECORD

Cased in., ft.

Sand

Gas

Oil

Total Depth

PRODUCTION

1st 24 hrs. Nat.

1st 24 hrs. after shot

Gas Cu. Ft.

Dry Hole

Abandoned

Date

9/2 191 9. Pyle Scout

Form 26—1M—4-19—Mid-West


Map No. K14 Sec. 17 Twp. 23 R. 4

Well No. 5 Lathrop

National Company

Contractor

SECTION PLAT

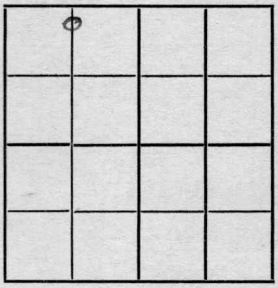

200 Ft. from N. Line

Ft. from S. Line

Ft. from E. Line

1320 Ft. from W. Line

Location

Rig up ✓

Drilling and Remarks:

RECORD

Cased in., ft.

Sand

Gas

Oil

Total Depth

PRODUCTION

1st 24 hrs. Nat.

1st 24 hrs. after shot

Gas Cu. Ft.

Dry Hole

Abandoned

Date

9/9/1919

Pyle Scout

Form 26—1M—4-19—Mid-West


Map No. K 14 Sec. 17 Twp. 23 R. 4

Well No. 5 Lathrop

National Company

Contractor

SECTION PLAT

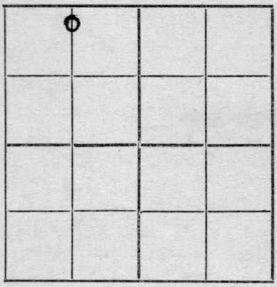

200 Ft. from N. Line

Ft. from S. Line

Ft. from E. Line

1320 Ft. from W. Line

Location

Rig up ✓

Drilling and Remarks:

RECORD

Cased in., ft.

Sand

Gas

Oil

Total Depth

PRODUCTION

1st 24 hrs. Nat.

1st 24 hrs. after shot

Gas Cu. Ft.

Dry Hole

Abandoned

Date

9/15/1919

Pyle

Scout

Form 26—1M—4-19—Mid-West


Map No. K14 Sec. 17 Twp. 23 R. 4

Well No. 5 Lathrop

National Company

Contractor

SECTION PLAT

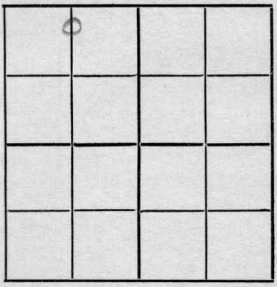

200 Ft. from N. Line

Ft. from S. Line

Ft. from E. Line

1320 Ft. from W. Line

Location

Rig up

Drilling and Remarks:

RECORD

Cased in., ft.

Sand

Gas

Oil

Total Depth

PRODUCTION

1st 24 hrs. Nat.

1st 24 hrs. after shot

Gas Cu. Ft.

Dry Hole

Abandoned

Date

9/23 191 9

Pyle Scout

Form 26—1M—4-19—Mid-West


Map No. K 14 Sec. 17 Twp. 23 R. 4

Well No. 5 Lathrop

National Company

Contractor

SECTION PLAT

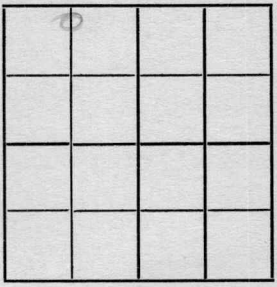

200 Ft. from N. Line

Ft. from S. Line

Ft. from E. Line

1320 Ft. from W. Line

Location

Rig up

Drilling and Remarks:

Rig in up

RECORD

Cased in., ft.

Sand

Gas

Oil

Total Depth

PRODUCTION

1st 24 hrs. Nat.

1st 24 hrs. after shot

Gas Cu. Ft.

Dry Hole

Abandoned

Date

9/30/19 9

Pyle Scout

Form 26—1M—4-19—Mid-West


Map No. K14 Sec. 17 Twp. 23 R. 4

Well No. 5 Lathrop

National Company

Contractor

SECTION PLAT

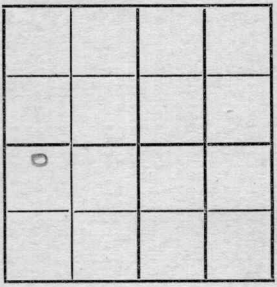

200 Ft. from N. Line

Ft. from S. Line

Ft. from E. Line

760 Ft. from W. Line

Location

Rig up

Drilling and Remarks:

Rig.

RECORD

Cased in., ft.

Sand

Gas

Oil

Total Depth

PRODUCTION

1st 24 hrs. Nat.

1st 24 hrs. after shot

Gas Cu. Ft.

Dry Hole

Abandoned

Date

10/14 191 9.

Pyle Scout

Form 26—1M—4-19—Mid-West


Map No. K14 Sec. 17 Twp. 23 R. 4

Well No. 5 Lathrop

National Company

Contractor

SECTION PLAT

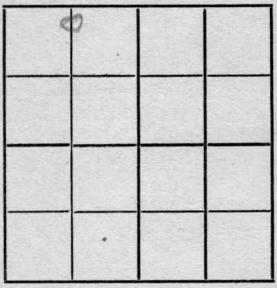

700 Ft. from N. Line

Ft. from S. Line

Ft. from E. Line

1320 Ft. from W. Line

Location

Rig up

Drilling and Remarks:

675' Dry.

RECORD

Cased in., ft.

Sand

Gas

Oil

Total Depth

PRODUCTION

1st 24 hrs. Nat.

1st 24 hrs. after shot

Gas Cu. Ft.

Dry Hole

Abandoned

Date

10/14/1919

Pyle Scout

Form 26—1M—4-19—Mid-West


Map No. 514 Sec. 17 Twp. 23 R. 4

Well No. 5 Lathrop

National Company

Contractor

SECTION PLAT

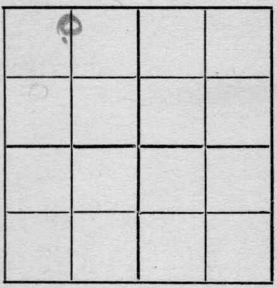

200 Ft. from N. Line

Ft. from S. Line

Ft. from E. Line

1320 Ft. from W. Line

Location

Rig up

Drilling and Remarks:

810'

RECORD

Cased in., ft.

Sand

Gas

Oil

Total Depth

PRODUCTION

1st 24 hrs. Nat.

1st 24 hrs. after shot

Gas Cu. Ft.

Dry Hole

Abandoned

Date

10/21/1919

Pyle Scout

Form 26—1M—4-19—Mid-West


Map No. K14 Sec. 17 Twp. 23 R. 4

Well No. 5 Lathrop

National Ref- Company

Contractor

SECTION PLAT

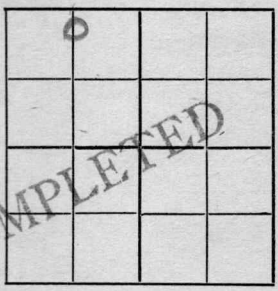

200 Ft. from N. Line

Ft. from S. Line

Ft. from E. Line

1320 Ft. from W. Line

COMPLETED

Location

Rig up

Drilling and Remarks:

RECORD

Cased in., ft.

Sand 2381-2391

Gas

Oil

Total Depth

PRODUCTION

1st 24 hrs. Nat. 50 bbls

1st 24 hrs. after shot

Gas Cu. Ft.

Dry Hole

Abandoned

Date

12/22/191 9

Pyle Scout