


Map No. **KANSAS** Sec. 1 Twp. 23 R. 14
Well No. 1-~~Hamsey~~ WILK Farm
Ellis et al Company

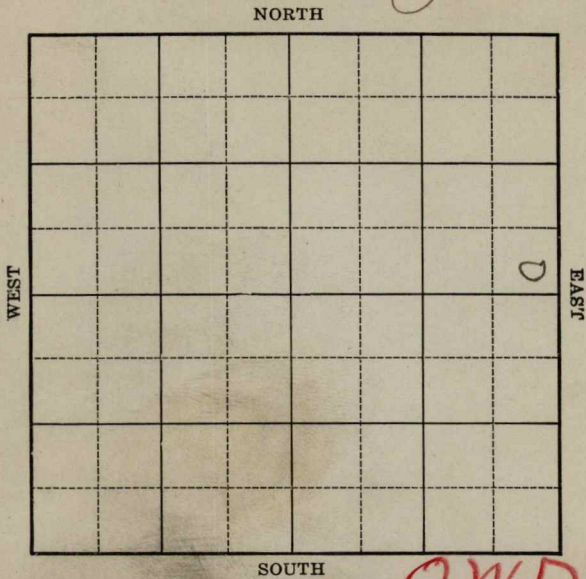

Location _____
Drilling Remarks _____

Rig Up _____
Drilling Remarks _____

RECORD


PRODUCTION

Cased _____ in. _____ ft.
Sand _____
Gas _____
Oil _____
Total Depth _____

1st 24 hrs. Nat. _____
1st 24 hrs. after shot _____
Gas _____ cu. ft.
Dry Hole _____
Abandoned _____

Map No. **KANSAS** Sec. 1 Twp. 23 R. 14
 Well No. 1 - Van Nooy **WILER** Farm
Ellis et al Company

NORTH

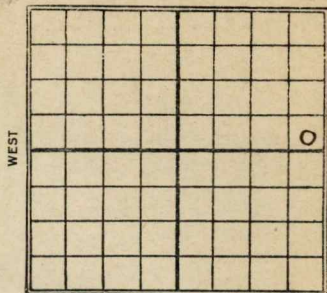

SOUTH

Ft. from N. Line

250 Ft. from S. Line250 Ft. from E. Line

Ft. from W. Line

1928

Date

REPORT

5/17 Location

5/24

5/31 Rigging up mch.

6/7

6/14

6/21

6/28

7/4 Drilg 15007/13 S/D 1500

7/19

7/26 Drilg 15558/2 S.D. 1555

8/9

8/16 Sand 1150-68 1 1/4 m Gas

" 1200-55 3 9/16 m Gas

1265-75 Dry

Top line 1523

Show oil 1576-80

Abandoned 1581

1929

1/2 Top line 1523-81' - T.D.

4 M cu ft gas

KANSASMAP NO. no mining SEC. 1 TWP. 23 R. 14^EWELL NO. 01 Van RoyEllis et al

COMPANY

CONTRACTOR

FIRST REPORTS

____ FT. FROM N. LINE

750 FT. FROM S. LINE750 FT. FROM E. LINE

____ FT. FROM W. LINE

SECTION PLAT

			0

LOCATION ✓

RIG UP _____

DRILLING AND REMARKS:

RECORD

CASED _____ IN. _____ FT.

SAND _____

GAS _____

OIL _____

TOTAL DEPTH _____

PRODUCTION

1ST 24 HRS. NAT. _____

1ST 24 HRS. AFTER SHOT _____

GAS _____ CU. FT.

DRY HOLE _____

ABANDONED _____

DATE

MAY 17 1928

192

CHAS. L. SHERWOOD

SCOUT

Map No. 1 Sec. 1 Twp. 23 R. 14

Well No. 1 Uow ray

Ellis et al Company

Contractor

COMPLETED

SECTION PLAT

_____ Ft. from N. Line

250 Ft. from S. Line

250 Ft. from E. Line

_____ Ft. from W. Line

ABANDONED

Location _____

Rig up _____

Drilling and Remarks:

and 1150-68 1 1/2 4900
" 1200-55 3 1/2 4900
" 1765-75 Dry
XL 1523
show dip 1576-80

RECORD

Cased _____ in., _____ ft.

Sand _____

Gas _____

Oil _____

Total Depth 1581'

PRODUCTION

1st 24 hrs. Nat. _____

1st 24 hrs. after shot. _____

Gas _____ Cu. Ft.

Dry Hole ☒

Abandoned ☒

Date

AUG 13 1928

CHAS. L. SHERWOOD

192

Scout

KANSAS

Map No. *none* Sec. *1* Twp. *73* R. *14*Well No. *Ellis* *Wiler* *Crab*

Company

FIRST REPORTS

Contractor

*Y**OWDD*

SECTION PLAT

COMPLETED

Ft. from N. Line

750

Ft. from S. Line

750

Ft. from E. Line

Ft. from W. Line

*was moved
Abandoned
T. D. 1581**2nd bucket*

Location

Rig up

Drilling and Remarks:

*Top Line 1573-1581**gas well.*

RECORD

Cased in., ft.

Sand

Gas

Oil

Total Depth *1581*

PRODUCTION

1st 24 hrs. Nat.

1st 24 hrs. after shot

Gas *4 1/2* Cu. Ft.

Dry Hole

Abandoned

Date

JAN 2 1929

CHAS. L. SHERWOOD

192

Scout