
FORM 51

Butler KANSAS

Section 5 Township 26 Range 4E

Well No. 25 Rice

Company Kewanee Oil

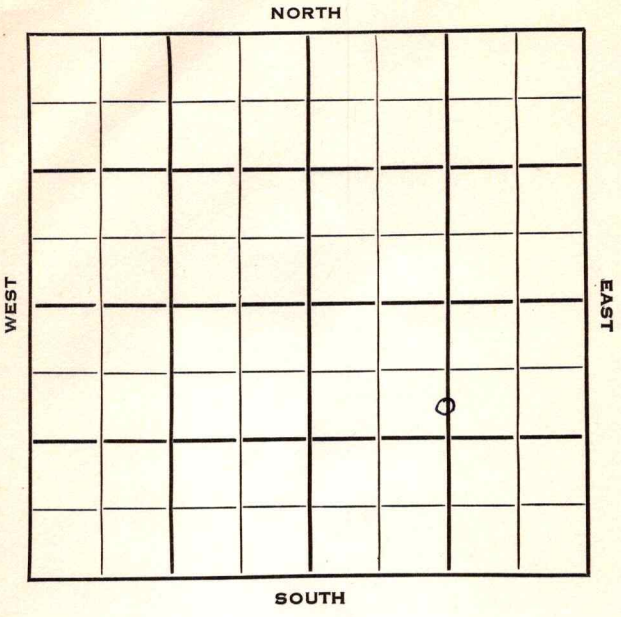

FORM 252-B

Butler KANSAS ✓

Sec. 5 Twp. 26 R. 4E

Well No. #25 Rice Farm

Kewanee Oil Company

Rex & Morris Contractor

Towanda Pool


990 Ft. from N. Line

Ft. from S. Line

1320 Ft. from E. Line

Ft. from W. Line

C S½ N½ SE

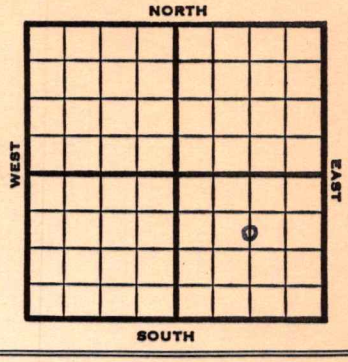

1953	Elev. 1266' REPORT
4/8	Spud 4-1-53 10" @ 100' KC 2004 TD 2066 7" @ 2057'
4/15	Spud 4-1-53 Oil Well TD 2066' 10" @ 100' KC 2004 TD 2066 7" @ 2057' CO to 2066, 2 boph 1000A Comp. 25 bopd.

COMPLETED

FORM 275 FOR SALE BY KANSAS BLUE PRINT CO.


County Butler State Kansas

Sec. 5 (Blk. Twp.) 26 (Sur. Rge.) 4E Map No.

Operator Kewanee Oil

Well No. 25 Farm Rice

Elev. Location C S½ N½ SE

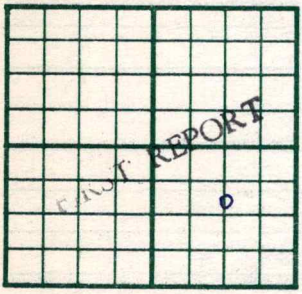

990 Ft. From N Line SE

1320 Ft. From E Line Quarter

1st. Report APR 8 1953

Completion

Remarks Rex & Morris - Contr.

Spudding Date 4-1-53

Drlg. Data Towanda Pool

10" @ 100 KC 2004 TD 2066 7" @ 2057

J. G. McGEHEE

FORM 275 FOR SALE BY KANSAS BLUE PRINT CO.

County Butler State Kansas

Sec. 5 (Blk. Twp.) 26 (Sur. Rge.) 4E Map No.

Operator Kewanee Oil

Well No. 25 Farm Rice

Elev. 1266 Location C S½ N½ SE



990 Ft. From N Line SE

1320 Ft. From E Line Quarter

1st. Report

Completion APR 1 5 1953

Remarks Towanda Pool

Rex & Morris - Contr.

Spudding Date 4-1-53

Drlg. Data Oil well TD 2066

10" @ 100 KC 2004 TD 2066 7" @ 2057

CO to 2066 2 boph 1000 A

Comp. 25 bopd

J. G. McGEHEE