FORM 51 25M 3-49 PETROL

KANSAS


Butler

Section 5 Township 26 Range 4E

Well No. 3 Waite

Company E. Adair et al

Misc.

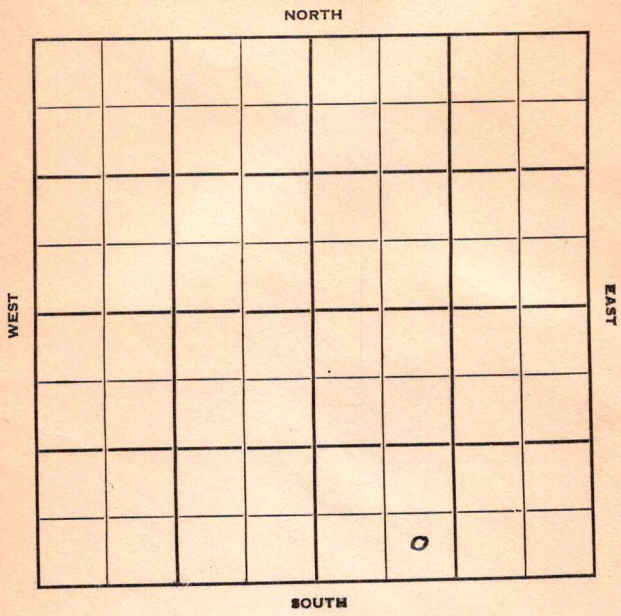

FORM 252-A
5M 10-48 PETROL

KANSAS

Sec. 5 Twp. 26 Butler R. 4E ✓

Well No. #3 Waite Farm

E. Adair et al Company

Miscellaneous


_____ Ft. from N. Line

330' Ft. from S. Line

_____ Ft. from E. Line

990' Ft. from W. Line

SE SW SE

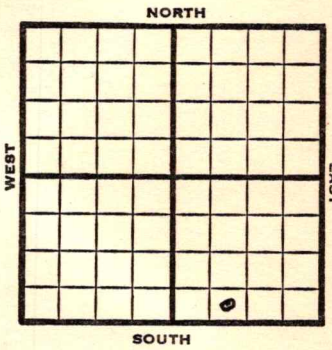

1949	Elev 1263' REPORT
4/20	Location
4/27	"
5/4	20" @ 30' 15" @ 183' Drlg. 420'
5/10	13" @ 890' Drlg. 1250'
5/18	Drlg 1800'
5/25	8"@ 2220' Drlg. 2460'
6/1	Viola 2471' TD 2503' 5" @ 2471'
6/7	TD 2493'
6/15	Viola 2471' 5"@ 2471' TD 2493' Pump 45 Oil Pot 38° Gr. Comp

COMPLETED

Form 26 200 Bks. 9-48 Petrol

Kansas

Miscellaneous

Map No. _____ Sec. 5 Twp. 26 R. 4E


Well No. 3 Waite

E. Adair etal. Company

FIRST REPORT Contractor

SE SW SE

SECTION PLAT

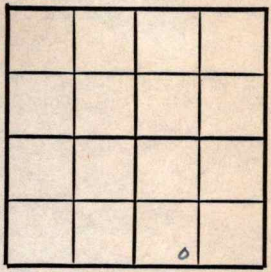

_____ Ft. from N. Line

330 Ft. from S. Line

_____ Ft. from E. Line

990 Ft. from W. Line

Butler County

Location x

Rig up _____

Drilling and Remarks:

RECORD

Cased _____ in., _____ ft.

Sand _____

Gas _____

Oil _____

Total Depth _____

PRODUCTION

1st 24 hrs. Nat. _____

1st 24 hrs. after shot _____

Gas _____ Cu. Ft.

Dry Hole _____

Abandoned _____

Date

APR 20 1949 19 S. J. LEWIS Scout

Form 27—100 Bks.—4-48—Petrol

Butler County Kansas State

Map No. KM Sec. 5 Twp. 26 R. 4E

Well No. 3 Waite


E. Adair etal. Company

COMPLETE Contractor

SE SW SE

E 1,263

SECTION PLAT

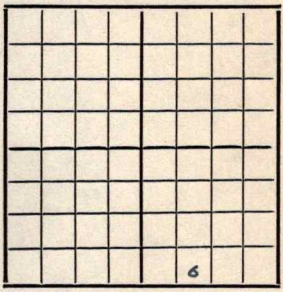

Ft. from N. Line

330 Ft. from S. Line

Ft. from E. Line

990 Ft. from W. Line

Miscellaneous

Remarks:

Viola 2471

5" @ 2471

TD 2493

Penn Mutual Bldg

38-Gr

Date JUN 15 1949

Scout S. J. LEWIS