
FORM 51 10M 8-47

KANSAS Butler

Section 5 Township 26 Range 4-E

Well No. #1 Waite

Company Rex & Morris etal

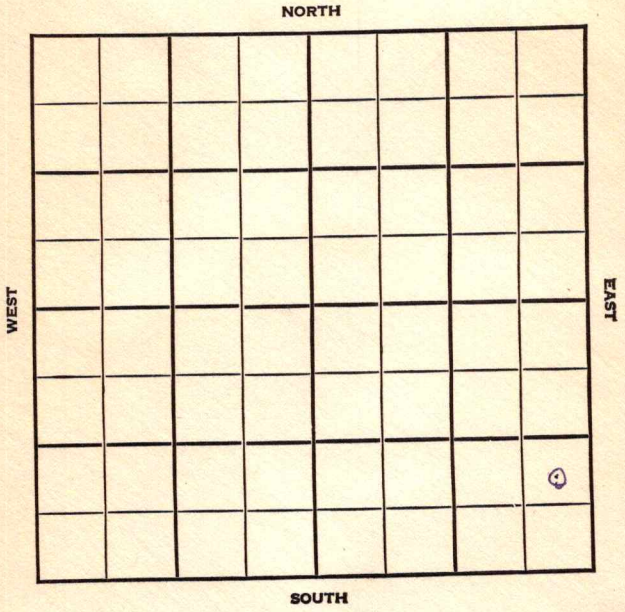

FORM 252-A
5M 4-48 PETROL

KANSAS Butler ✓

Sec. 5 Twp. 26 R. 4E

Well No. #1 Waite Farm

Rex & Morris et al Company

Miscellaneous


_____ Ft. from N. Line

990' Ft. from S. Line

330' Ft. from E. Line

_____ Ft. from W. Line

NE SE SE

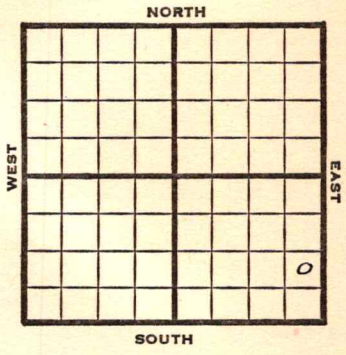

1948	Eli 1272' REPORT
7/21	Location
7/28	Mach
8/4	Drlg. 360'
m8/11	13"@ 880'
	Drlg 1375'
8/18	10"@ 1685'
	Lansing 1730'
	Drlg 1870'
8/25	Kc 2035'
	8"@ 2140'
	Drlg 2462'
9/1	Viola 2552'
	TD 2569'
	Aband.
	ABANDONED

Form 26—200 Bks.—1-48—Palace

Kansas Miscellaneous

Map No. _____ Sec. 5 Twp. 26 R. 4E


Well No. 1 Waite

Rex & Morris etal. Company

FIRST REPORT Contractor

NE SE SE

SECTION PLAT

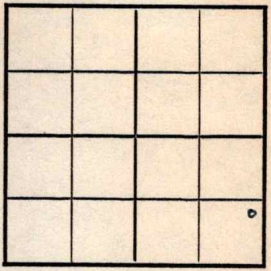

_____ Ft. from N. Line

990 Ft. from S. Line

330 Ft. from E. Line

_____ Ft. from W. Line

Butler County

Location x

Rig up _____

Drilling and Remarks:

RECORD

Cased _____ in., _____ ft.

Sand _____

Gas _____

Oil _____

Total Depth _____

PRODUCTION

1st 24 hrs. Nat. _____

1st 24 hrs. after shot _____

Gas _____ Cu. Ft.

Dry Hole _____

Abandoned _____

Date

JUL 21 1948 19____ S. J. LEWIS Scout

Form 27—100 Bks.—4-48—Petrol

Butler County Kansas State

Map No. 14 Sec. 5 Twp. 26 R. 4E

Well No. 1 Waite


Rex & Morris etal. Company

ABANDONED Contractor

NE SE SE

E 1/2 NE 1/4

SECTION PLAT

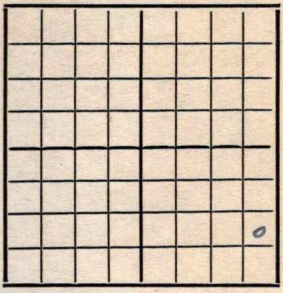

____ Ft. from N. Line

990 Ft. from S. Line

330 Ft. from E. Line

____ Ft. from W. Line

Miscellaneous

Remarks:

Viola 2552

KTJ 2569

Misc. Small Maps
Cards
Tracing
Prance Map
Scarborough Map
Pierce Map
Cooke Map

Date SEP 1 1948

Scout S. J. LEWIS