FORM 51 10M 7-48 PETROL

KANSAS


Butler

Section 5 Township 26 Range 4E

Well No. 2 Waite

Company Rex & Morris et al

Misc.

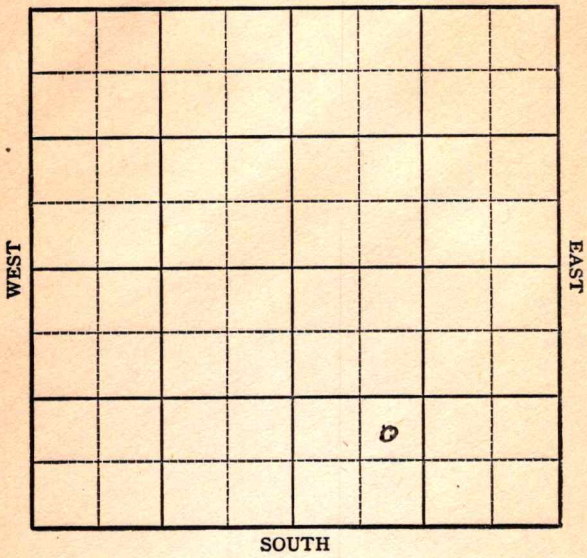

FORM 252-A
5M 10-48 PETROL


KANSAS Butler

Sec. 5 Twp. 26 R. 4-E ✓

Well No. #2 Waite Farm

Rex & Morris etal Company

Miscellaneous

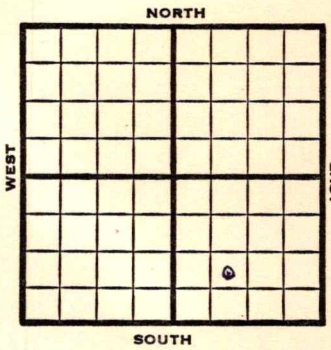

_____ Ft. from N. Line

990 Ft. from S. Line

_____ Ft. from E. Line

990 Ft. from W. Line

NE SW SE

	REPORT
1948	Eli 1262'
11/3 11/10	Location Drlg 110'
11/16	15" @ 175' 12" @ 825' Drlg. 925'
11/23	1700 Run 10"
11/30	10"@ 1700' Lansing 1710' KC 2010' 8"@ 2170' Drlg 2180'
12/8	TD 2469' Viola 2444' 6"@ 2445' Pump 50 Oil Pot 40° Gr. Comp COMPLETED

Form 26 200 Bks. 9-48 Petrol

Kansas

Miscellaneous

Map No. _____ Sec. 5 Twp. 26 R. 4E


Well No. 2 Waite

Rex & Morris etal. Company

FIRST REPORT Contractor

NE SW SE

SECTION PLAT

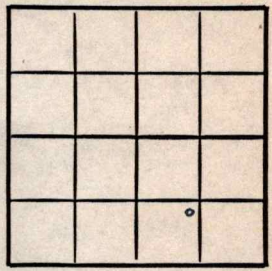

_____ Ft. from N. Line

990 Ft. from S. Line

_____ Ft. from E. Line

990 Ft. from W. Line

Butler County

Location x

Rig up

Drilling and Remarks:

RECORD

Cased _____ in., _____ ft.

Sand

Gas

Oil

Total Depth

PRODUCTION

1st 24 hrs. Nat.

1st 24 hrs. after shot

Gas _____ Cu. Ft.

Dry Hole

Abandoned

Date

NOV 3 1948 19

S. J. LEWIS Scout

Form 26 200 Bks. 9-48 Petrol

Kansas

Miscellaneous

Map No. 14 Sec. 5 Twp. 26 R. 4E

Well No. 2 Waite


Rex & Morris etal. Company

COMPLETE Contractor

NE SW SE

E.1262

SECTION PLAT

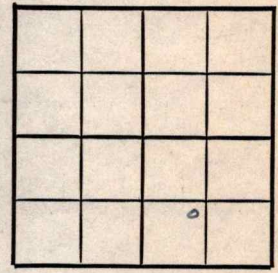

____ Ft. from N. Line

990 Ft. from S. Line

____ Ft. from E. Line

990 Ft. from W. Line

Butler County

Location

Rig up

Drilling and Remarks:

Viola 2444

6" @ 2445

Pump 50 oil BH

440 2 Gr

RECORD

Cased ____ in., ____ ft.

Sand

Gas

Oil /

Total Depth 2468

PRODUCTION

1st 24 hrs. Nat.

1st 24 hrs. after shot

Gas ____ Cu. Ft.

Dry Hole

Abandoned

Date

DEC 8 1948

19

S. J. LEWIS Scout