
Form 51—10M—8-19—CroMac

Map No. _____ Sec. 17 Twp. 23 R. 4

Well No. 7 Fairhope Farm

Ramsey Pet. Company

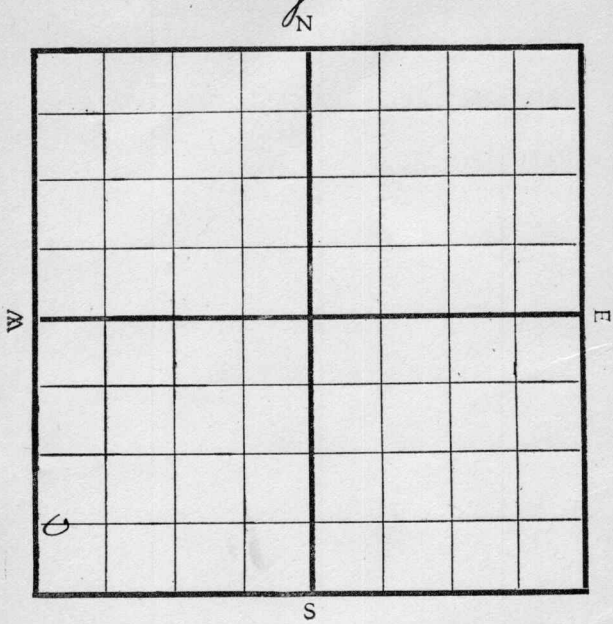

Location _____

Drilling Remarks:

Rig Up _____

Drilling Remarks:

COMPLETED

RECORD

Cased _____ in. _____ ft.

Sand _____

Gas _____

Oil _____

Total Depth _____

PRODUCTION

1st 24 hrs. Nat. _____

1st 24 hrs. after shot _____

Gas _____ cu. ft.

Dry Hole _____

Abandoned _____

Form 252A—6M-11-19-CroMac.

Map No. _____ Sec. 17 Twp. 23 R. 4

Well No. T. Jackrop Farm


Ramsey Pet. Co. Company

_____ Ft. from N. Line

660 Ft. from S. Line

_____ Ft. from E. Line

700 Ft. from W. Line

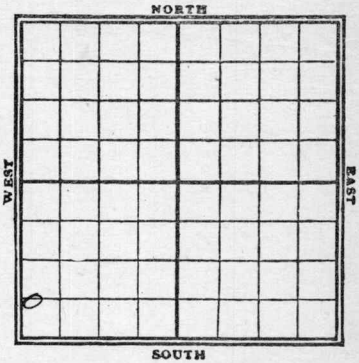

Date	REPORT
1919	
12/27	Rig up.
1/4/20	Rig up.
6	Spud.
14	Drl 6300'.
19	Drl 1200'
27	Drl 1900'
2/2	TD 1920'
9	Drlg. 2200'
16	2436'-45' 1500' oil
23	Sand 2436'-45'-Run 5 3/16
3/1	Sand 2436-45'-Trying to shut off
8	Sand 2436'-45'-1500' water
	Oil & water
15	2436'-45' Trying to shut water
29	2436'-45' D & A

FIRST REPORT

COMPLETED

Form 26—1M—4-19—Mid-West

Map No. K14 Sec. 17 Twp. 23 R. 4

Well No. 7 Lathrop

Ramsey Oil Company

Contractor

SECTION PLAT



Ft. from N. Line

660 Ft. from S. Line

Ft. from E. Line

200 Ft. from W. Line

Location

Rig up ✓

Drilling and Remarks:

RECORD

Cased in., ft.

Sand

Gas

Oil

Total Depth

PRODUCTION

1st 24 hrs. Nat.

1st 24 hrs. after shot

Gas Cu. Ft.

Dry Hole

Abandoned

Date

12/22 1919

Pyle Scout

Form 26—1M—4-19—Mid-West

Map No. K14 Sec. 17 Twp. 23 R. 4

Well No. 7 Lathrop

Ramsey Oil Company

Contractor

SECTION PLAT



Ft. from N. Line

660 Ft. from S. Line

Ft. from E. Line

200 Ft. from W. Line

Location

Rig up

Drilling and Remarks:

RECORD

Cased in., ft.

Sand 2436-45

Gas

Oil

Total Depth

PRODUCTION

1st 24 hrs. Nat.

1st 24 hrs. after shot

Gas Cu. Ft.

Dry Hole 2451

Abandoned

Date

3/29/1920

Pyle

Scout

Butler

FORM 26 250 BKS. 4-28 WESTERN

K14 KANSAS

MAP NO. _____ SEC. 17 TWP. 23S R. 4E


WELL NO. 7 Lathrop

Ramsey Pet COMPANY

CONTRACTOR

ABANDONED

SECTION PLAT

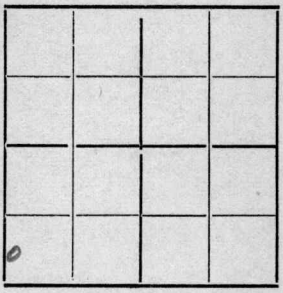

_____ FT. FROM N. LINE

_____ FT. FROM S. LINE

_____ FT. FROM E. LINE

_____ FT. FROM W. LINE

LOCATION _____

RIG UP _____

DRILLING AND REMARKS:

RECORD

CASED _____ IN., _____ FT.

SAND _____

GAS _____

OIL _____

TOTAL DEPTH 2451

PRODUCTION

1ST 24 HRS. NAT. _____

1ST 24 HRS. AFTER SHOT _____

GAS _____ CU. FT.

DRY HOLE _____

ABANDONED _____

DATE

3/29 1920 _____ SCOUT