
Form 51 5M 11-23 13896

Map No. K Sec. 20 Twp. 23 R. 13

Well No. 6 Hubbin Farm

R. S. Gillespie Company

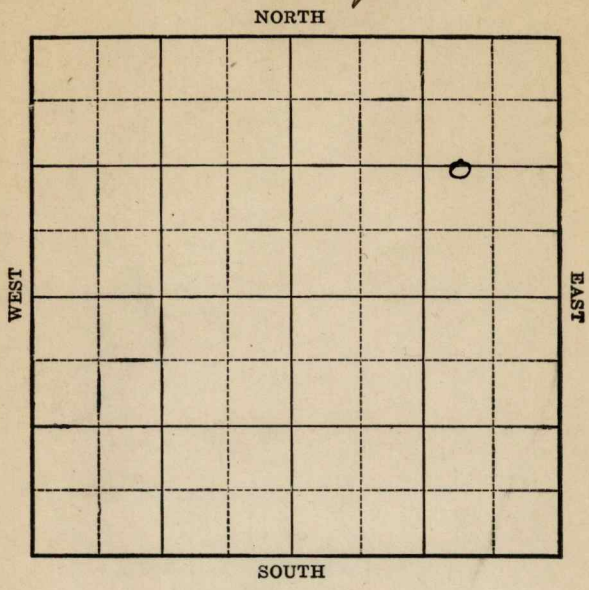

Location _____

Drilling Remarks:

Rig Up _____

Drilling Remarks:

RECORD

Cased _____ in. _____ ft.

Sand _____

Gas _____

Oil _____

Total Depth _____

PRODUCTION

1st 24 hrs. Nat. _____

1st 24 hrs. after shot _____

Gas _____ cu. ft.

Dry Hole _____

Abandoned _____

Form 252A 5M 4-22 8765

Map No. K Sec. 20 Twp. 23 R. 13

Well No. 6 Gribbin Farm


R. G. Gillespie Company

1320 Ft. from N. Line

_____ Ft. from S. Line

760 Ft. from E. Line

_____ Ft. from W. Line

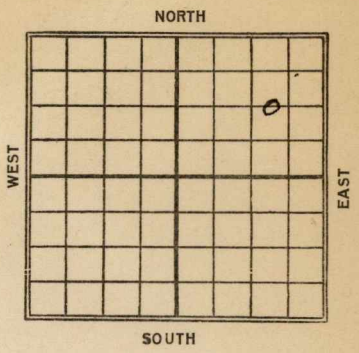

Date	REPORT
3/19	Spud
4/9	Ty Lm. 1753-
	Pay 1765-81
	60/15 Bbls

Form 26—1M Bks.—3-23—11959.

Map No. KANSAS 17 Sec. 20 Twp. 23 R. 19

Well No. 6 - Griblin

R. G. Gillespie Company

Contractor

FIRST REPORT


1326 Ft. from N. Line

Ft. from S. Line

760 Ft. from E. Line

Ft. from W. Line

SECTION PLAT

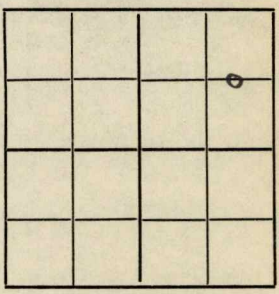

Location

Rig up

Drilling and Remarks:

spud

RECORD

Cased in., ft.

Sand

Gas

Oil

Total Depth

PRODUCTION

1st 24 hrs. Nat.

1st 24 hrs. after shot

Gas Cu. Ft.

Dry Hole

Abandoned

Date

FEB 1 9 1924

192

M. A. BENEAR

Scout

Form 26—1M Bks.—3-23—11959.

Map No. KANSAS 17 Sec. 20 Twp. 23 R. 13

Well No. 6 Gribbin


R. G. Gillespie Company

Contractor

COMPLETED

FARM

SECTION PLAT

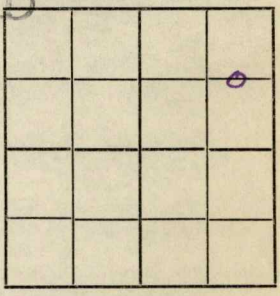

1320 Ft. from N. Line

Ft. from S. Line

760 Ft. from E. Line

Ft. from W. Line

Location

Rig up

Drilling and Remarks:

Inj L. 1753

Pay 1765-81

60/15 bbls

RECORD

Cased in., ft.

Sand

Gas

Oil

Total Depth

PRODUCTION

1st 24 hrs. Nat.

1st 24 hrs. after shot

Gas Cu. Ft.

Dry Hole

Abandoned

Date

APR 9 1924

M. A. BENEAR

192 Scout