
Form 51—5-19—5M—Mid-West

Map No. _____ Sec. 17 Twp. 23 R. 4

Well No. 10 Lathrop Farm

_____ National _____ Company

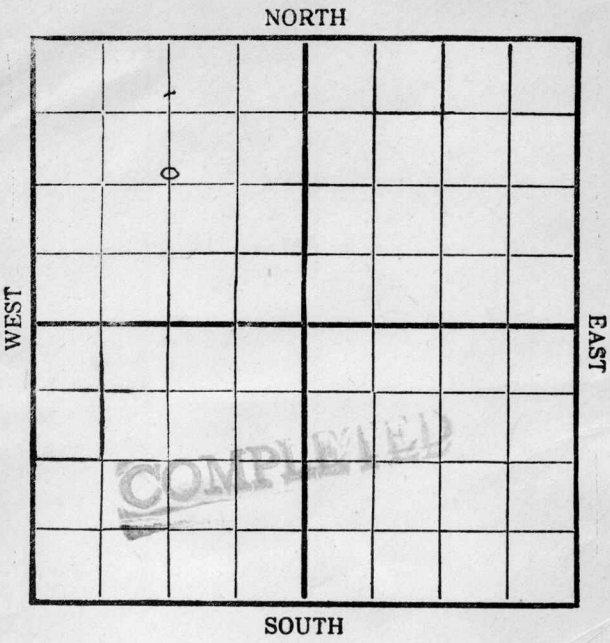

Location _____

Drilling Remarks:

Rig Up _____

Drilling Remarks:

RECORD

Cased _____ in. _____ ft.

Sand _____

Gas _____

Oil _____

Total Depth _____

PRODUCTION

1st 24 hrs. Nat. _____

1st 24 hrs. after shot _____

Gas _____ cu. ft.

Dry Hole _____

Abandoned _____

Form 252A 2M-9-19-CroMac.

Map No. _____ Sec. 17 Twp. 23 R. 4

Well No. 10 Lathrop Farm

National Oil & Gas Co. Company

_____ Contractor


NW Quarter

1120 Ft. from N. Lice

_____ Ft. from S. Line

1320 Ft. from E. Line

_____ Ft. from W. Line

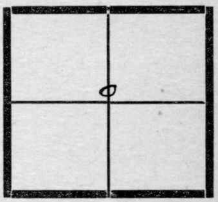

Date	REPORT
~~Aug~~	
9/11	Spud
10/21	Rig up
10/31	Spudded & Shut Down
11/4	200
12	S D 1320
19	DR 1650
25	" 1770'
12/2	DR 2070
9	" 2335'
16	Sand 2341-42 - 200' fluid in hole
23	Dry. 2347-2357½ 1000 Bbls

COMPLETED COMPLETED COMPLETED

Form 26—1M—4-19—Mid-West

Map No. K 14 Sec. 17 Twp. 23 R. 4

Well No. 10 Lathrop

National Ref Company

Contractor

SECTION PLAT



1120 Ft. from N. Line

Ft. from S. Line

Ft. from E. Line

1320 Ft. from W. Line

Location

Rig up

Drilling and Remarks:

RECORD

Cased in., ft.

Sand

Gas

Oil

Total Depth

PRODUCTION

1st 24 hrs. Nat.

1st 24 hrs. after shot

Gas Cu. Ft.

Dry Hole

Abandoned

Date

9/15/1919

Pyle Scout

Form 26—1M—4-19—Mid-West


Map No. K14 Sec. 17 Twp. 23 R. 4

Well No. 10 Lathrop

National Company

Contractor

SECTION PLAT

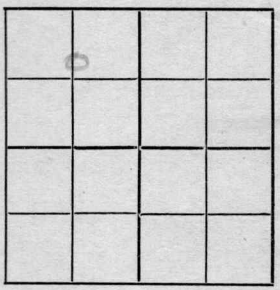

1120 Ft. from N. Line

Ft. from S. Line

Ft. from E. Line

1320 Ft. from W. Line

Location

Rig up ✓

Drilling and Remarks:

RECORD

Cased in., ft.

Sand

Gas

Oil

Total Depth

PRODUCTION

1st 24 hrs. Nat.

1st 24 hrs. after shot

Gas Cu. Ft.

Dry Hole

Abandoned

Date

9/23/191 9

Pyle Scout

Form 26—1M—4-19—Mid-West


Map No. 514 Sec. 17 Twp. 23 R. 4

Well No. 10 Lathrop

National Company

Contractor

SECTION PLAT

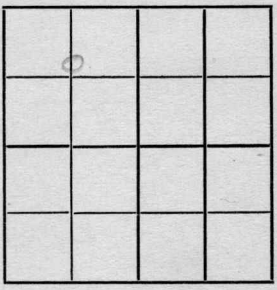

1120 Ft. from N. Line

Ft. from S. Line

Ft. from E. Line

1320 Ft. from W. Line

Location

Rig up ✓

Drilling and Remarks:

RECORD

Cased in., ft.

Sand

Gas

Oil

Total Depth

PRODUCTION

1st 24 hrs. Nat.

1st 24 hrs. after shot

Gas Cu. Ft.

Dry Hole

Abandoned

Date

9/30/1919

Pyle Scout

Form 26—1M—4-19—Mid-West


Map No. 15 14 Sec. 17 Twp. 23 R. 4

Well No. 10 Lathrop

National Company

Contractor

SECTION PLAT

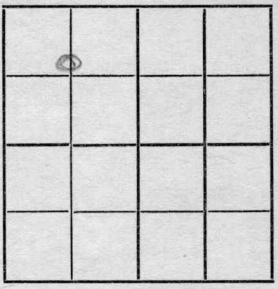

1120 Ft. from N. Line

Ft. from S. Line

Ft. from E. Line

1320 Ft. from W. Line

Location

Rig up

Drilling and Remarks:

Tools,

RECORD

Cased in., ft.

Sand

Gas

Oil

Total Depth

PRODUCTION

1st 24 hrs. Nat.

1st 24 hrs. after shot

Gas Cu. Ft.

Dry Hole

Abandoned

Date

10/14 191 9.

Pyle Scout

Form 26—1M—4-19—Mid-West


Map No. K14 Sec. 17 Twp. 23 R. 4

Well No. 10 Lathrop

National Company

Contractor

SECTION PLAT

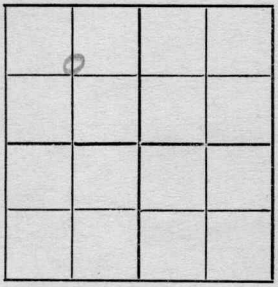

1170 Ft. from N. Line

Ft. from S. Line

Ft. from E. Line

1320 Ft. from W. Line

Location

Rig up

Drilling and Remarks:

Rig'n up

RECORD

Cased in., ft.

Sand

Gas

Oil

Total Depth

PRODUCTION

1st 24 hrs. Nat.

1st 24 hrs. after shot

Gas Cu. Ft.

Dry Hole

Abandoned

Date

10/21 191 9.

Pyle Scout

Form 26—1M—4-19—Mid-West


Map No. K 14 Sec. 17 Twp. 23 R. 4

Well No. 10 Lathrop

National Ref- Company

Contractor

SECTION PLAT

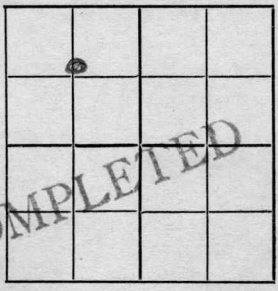

1120 Ft. from N. Line

Ft. from S. Line

Ft. from E. Line

1320 Ft. from W. Line

COMPLETED

Location

Rig up

Drilling and Remarks:

RECORD

Cased in., ft.

Sand 2347-2357

Gas

Oil

Total Depth

PRODUCTION

1st 24 hrs. Nat. 1000 bbls

1st 24 hrs. after shot

Gas Cu. Ft.

Dry Hole

Abandoned

Date

12/22 1919

Pyle Scout