
Form 51-10M-7-20-CroMac Kansas

Map No. _____ Sec. 20 Twp. 23 R. 13

Well No. 5 Swanson Farm

R. G. Gillespie Company

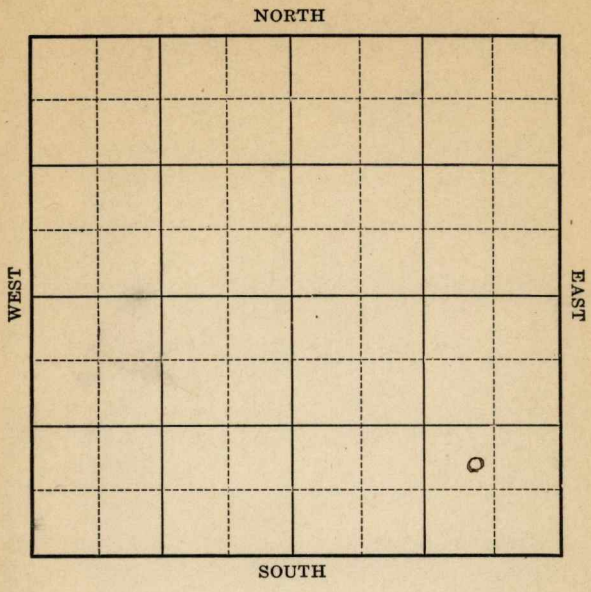

Location _____

Drilling Remarks:

Rig Up _____

Drilling Remarks:

RECORD

Cased _____ in. _____ ft.

Sand _____

Gas _____

Oil _____

Total Depth _____

PRODUCTION

1st 24 hrs. Nat. _____

1st 24 hrs. after shot _____

Gas _____ cu. ft.

Dry Hole _____

Abandoned _____

Form 252A 5M 4-22 8765

Map No. _____ Sec. 20 Twp. 23 R. 13

Well No. #5 Swanson Farm


R G Gillespie Company

_____ Ft. from N. Line

920 Ft. from S. Line

760 Ft. from E. Line

_____ Ft. from W. Line

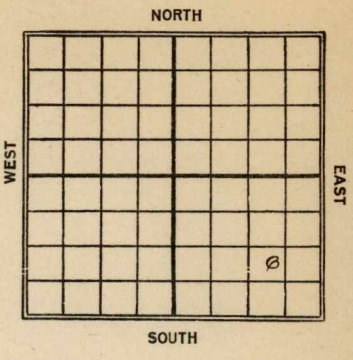

Date 1922	REPORT
7/27	Rig
9/16	Sand 1703-22-100 Bbls.
1923	
8/24	Sand 1703- J.D. 1722
	100 Bbls. Nat.

Form 26—1M—4-19—Mid-West

Map No. K17 Sec. 20 Twp. 23 R. 13

Well No. 5 Swanson

R. G. Gillespie Company

Contractor

FIRST REPORT


920' Ft. from N. Line

Ft. from S. Line

760' Ft. from E. Line

Ft. from W. Line

SECTION PLAT

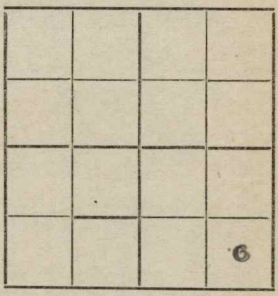

Location

Rig up

Drilling and Remarks:

Rig!

RECORD

Cased in., ft.

Sand

Gas

Oil

Total Depth

PRODUCTION

1st 24 hrs. Nat.

1st 24 hrs. after shot

Gas Cu. Ft.

Dry Hole

Abandoned

Date

JUL 27 1922

191

M. A. BENEAR

Scout

Form 26—1M—4-19—Mid-West

Map No. KANSAS Sec. 17 20 Twp. 33 R. 13


Well No. 3 Swanson

R. G. Gillespie Company

_____ Contractor

COMPLETED

SECTION PLAT

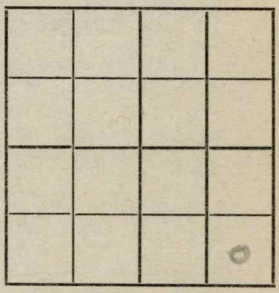

_____ Ft. from N. Line

920 Ft. from S. Line

760 Ft. from E. Line

_____ Ft. from W. Line

Location _____

Rig up _____

Drilling and Remarks:

RECORD

Cased _____ in., _____ ft.

Sand _____

Gas _____

Oil 1703-22

Total Depth _____

PRODUCTION

1st 24 hrs. Nat. 120

1st 24 hrs. after shot _____

Gas _____ Cu. Ft.

Dry Hole _____

Abandoned _____

Date

SEP 16 1922

_____ 191____.

M. A. BENEAR

_____ Scout

Form 26—1M Bks.—3-23—11959.

Map No. KANSAS 17 Sec. 20 Twp. 23 R. 13

Well No. 5 Swanson


R. G. Gillespie Company

Contractor

Correct Location

COMPLETED

SECTION PLAT

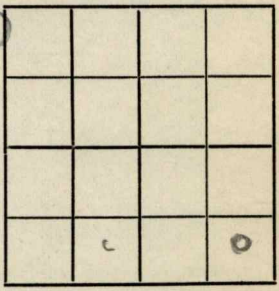

920 Ft. from S. Line

760 Ft. from E. Line

Ft. from N. Line

Ft. from W. Line

Location

Rig up

Drilling and Remarks:

sand 1703 to 1722 100 bbls Nat.

RECORD

Cased in., ft.

Sand

Gas

Oil

Total Depth

PRODUCTION

1st 24 hrs. Nat.

1st 24 hrs. after shot

Gas Cu. Ft.

Dry Hole

Abandoned

Date AUG 24 1923

AUG 24 1923

192

M. A. BENEAR

Scout