
Form 51—10M—8-19—CroMac

Map No. _____ Sec. 17 Twp. 23 R. 4

Well No. 13 Lathrop Farm

National Ref. Company

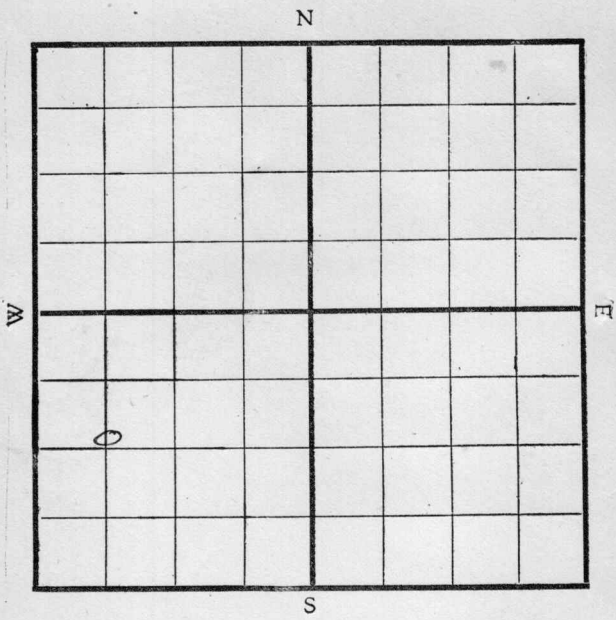

Location _____

Drilling Remarks:

Rig Up _____

Drilling Remarks:

COMPLETED

RECORD

Cased _____ in. _____ ft.

Sand _____

Gas _____

Oil _____

Total Depth _____

PRODUCTION

1st 24 hrs. Nat. _____

1st 24 hrs. after shot _____

Gas _____ cu. ft.

Dry Hole _____

Abandoned _____

Form 252A—6M-11-19-CroMac.

Map No. _____ Sec. 17 Twp. 23 R. 4

Well No. 13. Lathrop Farm


National Refg Co. Company

1120 Ft. from N. Line

_____ Ft. from S. Line

_____ Ft. from E. Line

660 Ft. from W. Line

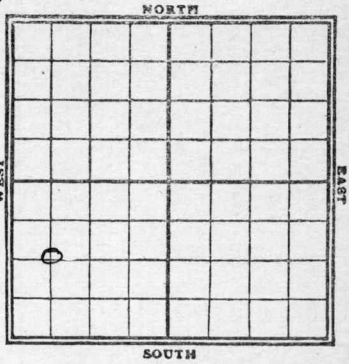

1919	REPORT
11/25	Timbers all Ground.
12/2	Timbers
9	Timbers
16	T. O. G.
23	Timbers
1/4/20	Rig up
6	Tbge.
14	Tools.
19	Spud
27	Drl 375'
2/2	Drl 775'
9	Drlg. 1240'
16	" 1735'
23	Drlg 2020'
3/1	Ust. 8 1/4" — to 2155'
8	Drlg 2155'
15	U. R. 8" @ 2155'
29	2381' - 93' - 200 Nat

COMPLETED

Form 26—1M—4-19—Mid-West

Map No. K14 Sec. 17 Twp. 23 R. 4

Well No. 13 Lathrop

National Ref- Company

Contractor

SECTION PLAT



1120 Ft. from N. Line

Ft. from S. Line

Ft. from E. Line

660 Ft. from W. Line

Location

Rig up

Drilling and Remarks:

J. O. G.

RECORD

Cased in., ft.

Sand

Gas

Oil

Total Depth

PRODUCTION

1st 24 hrs. Nat.

1st 24 hrs. after shot

Gas Cu. Ft.

Dry Hole

Abandoned

Date

11/25 19

Pyle Scout

Form 26—1M—4-19—Mid-West

Map No. K14 Sec. 17 Twp. 23 R. 4

Well No. 13 Lathrop

National Ref Company

Contractor

SECTION PLAT



1120 Ft. from N. Line

Ft. from S. Line

Ft. from E. Line

660 Ft. from W. Line

Location

Rig up

Drilling and Remarks:

RECORD

Cased in., ft.

Sand 2381-93

Gas

Oil

Total Depth

PRODUCTION

1st 24 hrs. Nat. 200 bbls

1st 24 hrs. after shot

Gas Cu. Ft.

Dry Hole

Abandoned

Date

3/29 1920

Pyle Scout