
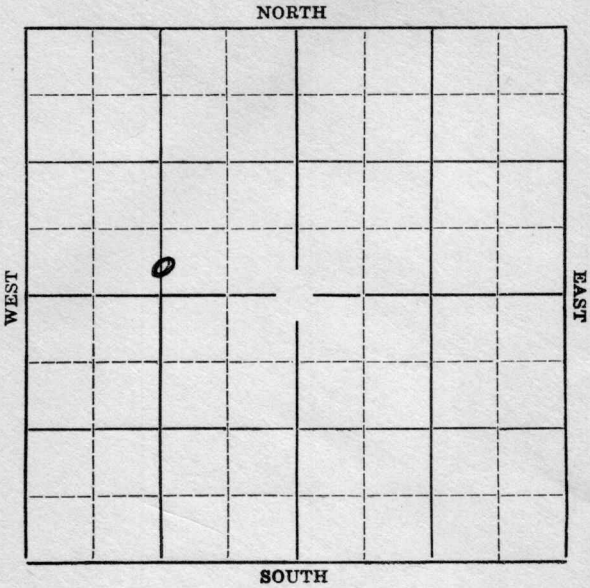


Section 17 Township 23 Range 4-EWell Number #22
#15-LathropeCompany Empire

Well No. ~~#15~~ Lathrope Farm

Company

Ft. from W. Line

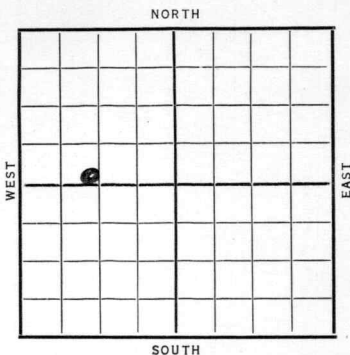

1966e	REPORT
9/9	Rig on ground.
9/18	--
9/24	Drlg. 970'.
10/1	10" @ 1136'. Drlg. 1785'.
10/8	Kansas City 1996'. Drlg. 1997'.
10/15	XXXXXXXXXXXXXXXXXXXXXXXXXXXXXX T.D. 2023' x 1000 gallons acid pump 65 bbls oil in 10 hours. XXXXXXXXXXXXXXXXXXXXXXXXXXXXXX T.D. 2080' x 2000 gallons acid. No test.
10/15	Show oil 2003-19' T.D. 2024'. 2000 gallons of acid. Pump 65 bbls of oil in 10 hours. T.D. 2080'. 2000 gallons of acid. No test.
10/21/36	-Kansas City 1996'. T.D. 2080'. 2000 gallons of acid. Potential 300 oil and 52 water.
	COMPLETED

KANSAS

Butter

Map No. 14 Sec. 17 Twp. 23 R. 4E

Well No. 15 Lathrop

Empire Company

Contractor

SECTION PLAT

 Ft. from N. Line

263 Ft. from S. Line

1835 Ft. from E. Line

 Ft. from W. Line

FIRST REPORT

Location

Rig up

Drilling and Remarks:

ROY

RECORD

Cased in., ft.

Sand

Gas

Oil

Total Depth

PRODUCTION

1st 24 hrs. Nat.

1st 24 hrs. after shot

Gas Cu. Ft.

Dry Hole

Abandoned

Date

SEP 9 1936 19

S. J. LEWIS

Scout

KANSAS

Map No. 14 Sec. 17 Twp. 23 R. 42Well No. 22 La TropeEmpire Company

Contractor

SECTION PLAT

 Ft. from N. Line263 Ft. from S. Line1335 Ft. from E. Line Ft. from W. Line

CORRECTION

Location Rig up

Drilling and Remarks:

Reported as
No 15

RECORD

Cased in., ft.Sand Gas Oil Total Depth

PRODUCTION

1st 24 hrs. Nat. 1st 24 hrs. after shot Gas Cu. Ft.Dry Hole Abandoned

Date

SEP 16 1936 19 S. J. LEWIS Scout

KANSAS

Map No. 14 Sec. 17 Twp. 23 R. 4EWell No. 22 La thropEmpire

Company

Contractor

SECTION PLAT

_____ Ft. from N. Line

263 Ft. from S. Line1335 Ft. from E. Line

_____ Ft. from W. Line

COMPLETED

Location _____

Rig up _____

Drilling and Remarks:

Kansas City 1996.2000 oil28300 oil52 water

RECORD

Cased _____ in., _____ ft.

Sand _____

Gas _____

Oil _____

Total Depth 2080

PRODUCTION

1st 24 hrs. Nat. _____

1st 24 hrs. after shot _____

Gas _____ Cu. Ft.

Dry Hole _____

Abandoned _____

Date

OCT 21 1936

19

S. J. LEWIS

Scout