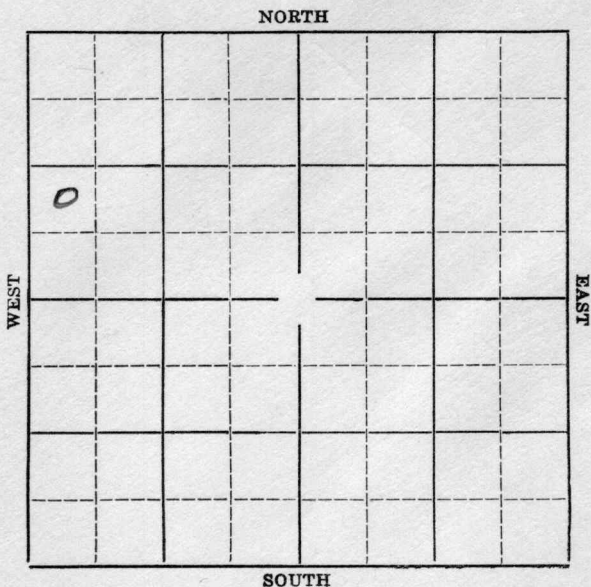
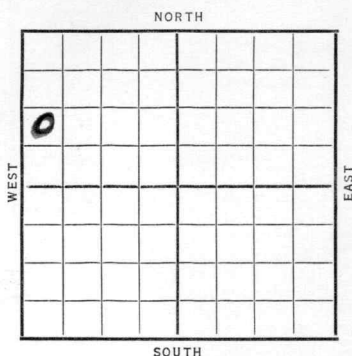


Section 17 Township 23 Range 4-EWell Number #23 LathropCompany Empire

Sec. 17 Twp. 23 R. 4EWell No. #23 Lathrop FarmEmpire. Company Ft. from N. Line990' Ft. from S. Line Ft. from E. Line330' Ft. from W. Line

1936	REPORT
10/21	Location.
10/29--	
11/6	Mach.
11/12	12" @ 93' Drlg. 170
11/19	Drlg. 920'.
11/27	10" @ 1140'. Drlg. 1258'.
12/3	8" @ 1835'.
12/10	Kansas city 1962'. 6" @ 2021'
	Show oil 2029-34'. T.D. 2044
12/17	T. D. 2078'. 2000 acid.
	Pump 300 bbls. oil 45 bbls.
	water 24 hrs.
12/22	Kansas city 2044'.
	T. D. 2103'. 2000 acid.
	Pot. 679 oil 191 water.
	COMPLETED

KANSAS

Map No. 14 Sec. 17 Twp. 23 R. 4E

Well No. 23 Lathrop

Empire Company

Contractor

SECTION PLAT

0			

 Ft. from N. Line

990 Ft. from S. Line

 Ft. from E. Line

330 Ft. from W. Line

FIRST REPORT

Location ✓

Rig up

Drilling and Remarks:

RECORD

Cased in., ft.

Sand

Gas

Oil

Total Depth

PRODUCTION

1st 24 hrs. Nat.

1st 24 hrs. after shot

Gas Cu. Ft.

Dry Hole

Abandoned

Date

OCT 21 1936

19

S. J. LEWIS

Scout

KANSAS

Map No. 14 Sec. 17 Twp. 23 R. 4E7Well No. 23 LathropEmpire

Company

Contractor

SECTION PLAT

0			

_____ Ft. from N. Line

990 Ft. from S. Line

_____ Ft. from E. Line

330 Ft. from W. Line

COMPLETED

Location _____

Rig up _____

Drilling and Remarks:

Kansas City 20442000 acidProd 679 oil191 water

RECORD

Cased _____ in., _____ ft.

Sand _____

Gas _____

Oil _____

Total Depth 2103

PRODUCTION

1st 24 hrs. Nat. _____

1st 24 hrs. after shot _____

Gas _____ Cu. Ft.

Dry Hole _____

Abandoned _____

Date

DEC 22 1936

19

S. J. LEWIS Scout