
FORM 51 25M 3-49 PETROL KANSAS

Butler

Section 5 Township 26 Range 4-E

Well No. #8 Waite

Company Rex & Morris

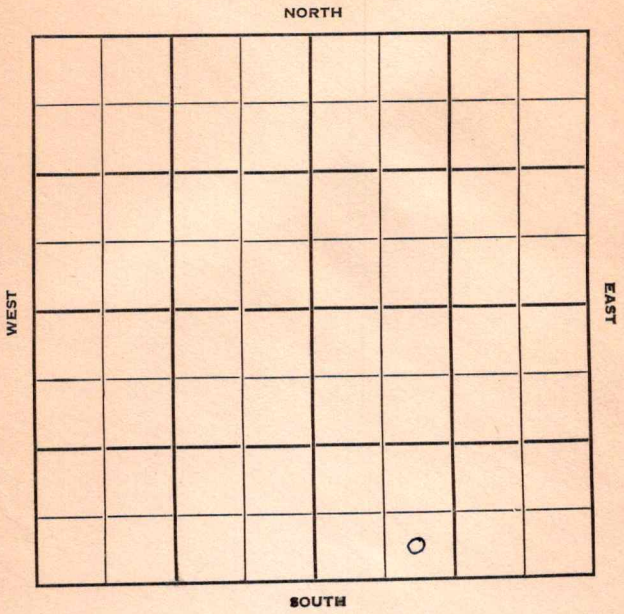

FORM 252-B
10M 9-49 PETROL

KANSAS

Sec. 5 Twp. 26 R. Butler 4-E

Well No. #8 Waite Farm

Rex & Morris Company

Contractor

Miscellaneous

Ft. from N. Line


330 Ft. from S. Line

Ft. from E. Line

990 Ft. from W. Line

SE SW SE

Twin to #3

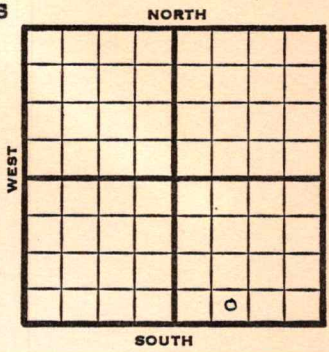

1950	Elev. 1262' REPORT
8/2	Location
9/13	Spd 8-9-50 Oil Well TD 2523' 15" @ 180' 13" @ 845' Simp. 2497' Viola 2464' Simp. 2496' 7" @ 2486' TD 2523' Comp. 35 BOPD COMPLETED

Form 26 200 Bks. 11-49 Petrol

Kansas

Map No. _____ Sec. 5 Twp. 26 R. 4E

Well No. 8 Waite

Rex & Morris Company

Contractor

SE SW SE Twin to #3

SECTION PLAT



_____ Ft. from N. Line

330 Ft. from S. Line

_____ Ft. from E. Line

990 Ft. from W. Line

Butler County

Location x

Rig up _____

Drilling and Remarks:

RECORD

Cased _____ in., _____ ft.

Sand _____

Gas _____

Oil _____

Total Depth _____

PRODUCTION

1st 24 hrs. Nat. _____

1st 24 hrs. after shot _____

Gas _____ Cu. Ft.

Dry Hole _____

Abandoned _____

Date

AUG 2 1950

19 J. E. TYRA Scout

FORM 275 FOR SALE BY KANSAS BLUE PRINT CO.


County Butler State Kansas

Sec. 5 (Blk. Twp.) 2 6 (Sur. Rge.) 4E Map No.

Operator Rex & Morris

Well No. 8 Farm Waite

Elev. 1262 Location SE SW SE

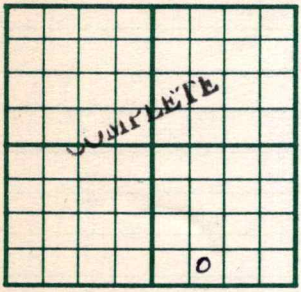

330 Ft. From S Line SE

990 Ft. From W Line Quarter

1st. Report

Completion SEP 1 3 1950

Remarks twin to #3

Miscellaneous

Spudding Date 8-9-50

Drlg. Data Oil well TD 2523

15" @ 180 13" @ 845 Simp. 2497

Viola 2464 Simp. 2496 7" @ 2486

TD 2523 Comp. 35 bopd

J. E. TYRA