


Section 21 Township 23 Range 13 E

Well No. # 6 V. M. Gribblin "B"

Company Mid-Continent Petroleum

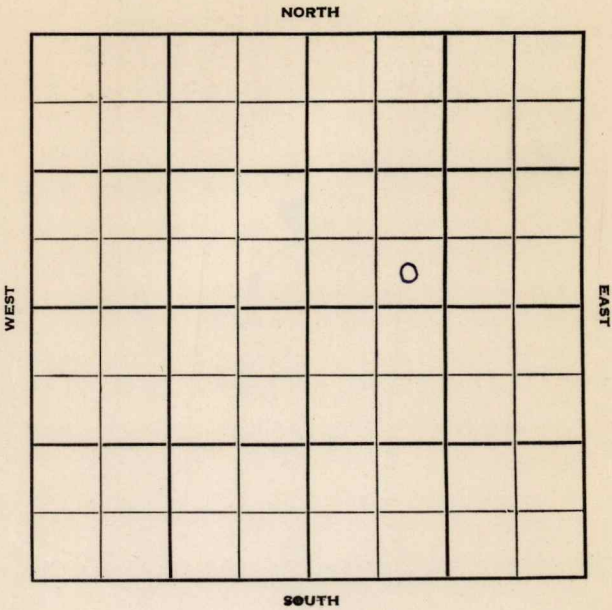

Sec. 21 Twp. 23S R. 13E ✓Well No. #6 Viola M. Griblin "B" Farm

Mid-Continent

Company

Jackman & Jackman

Contractor

Virgil Pool


Ft. from N. Line

330 Ft. from S. Line

Ft. from E. Line

990 Ft. from W. Line

SE SW NE

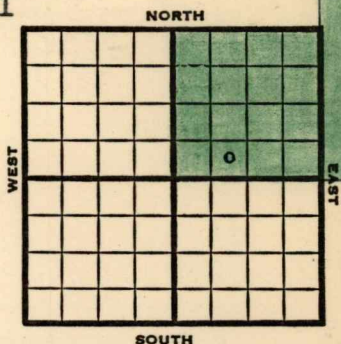


1951	Elev. --	REPORT
		1800' test
5/25		Location notice
5/28		Spudded 5-27-51 10-3/4" at 20' with 30 sacks. (D R)
5/29		WOC. "
5/31		Drilling 1480'. "
6/1		Drilling 1713'. "
6/4		7" at 1743' with 50 sacks. TD. 1744'. "
6/5		WOC. "
6/6		MI cable tools. drlg. plug. "
6/7		No report. "
6/8		1757'-60' soft, saturated sandy lime 20 gal. oil/ hr. TD. 1764'. "
6/11		Will hydrafrac. "
6/12		Hydrafrac, put in 130 bbls load, pumped back 90 bbls, test tomorrow. "
6/13		Testing after hydrafrac. "
6/14		Testing after hydrafrac. "
6/15		Comp. 6-15-51 20 BPD on pump. TD. 1764'. "
6/20		Spud 5-27-51 Oil well TD 1764' 10" @ 20 Miss 1738-44' 7" @ 1744' TD 1764' 20 GOPH Hydrofrac P/ 3 BO 1/2 BWPH for 12 hr. Comp. 35 BOPD

COMPLETED

J. E. TYRA

County Greenwood State Kansas
 Sec. 21 (Blk.) 23 (Sur.) 13E Map No.
 Operator Mid-Continent Petroleum Corp.
 Well No. 6 Farm V. M. Griblin "B"
 Elev. _____ Location SE SW NE

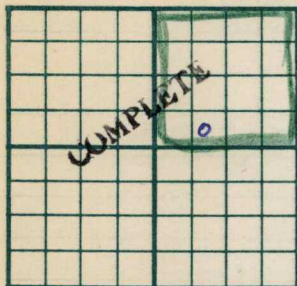

330 Ft. From S Line NE
990 Ft. From W Line Quarter

1st. Report

Completion JUN 20 1951

Remarks Virgil Pool

Jackman & Jackman - Contr

Spudding Date 5-27-51

Drlg. Data Oil well TD 1764

10" @ 20 Miss. 1738-44 7" @ 1744

TD 1764 20 goph Hydrofrac

P/ 3 bo $\frac{1}{2}$ bwph f or 12 hr.

Comp. 35 bopd

J. E. TYRA