

KANSAS

Section 17 Township 23 Range 4EWell No. 30 LathropCompany Cities Service


Miscellaneous

NORTH

WEST

EAST

SOUTH

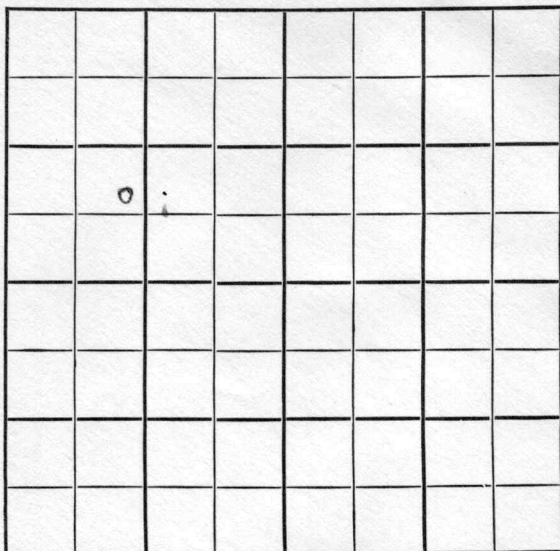

Butler

KANSAS

Sec. 17 Twp. 23 R. 4E

Well No. #30 Lathrop Farm

Cities Service Company

Miscellaneous

 Ft. from N. Line

840


 Ft. from S. Line

 Ft. from E. Line

1220

 Ft. from W. Line

C N L S $\frac{1}{2}$ NW

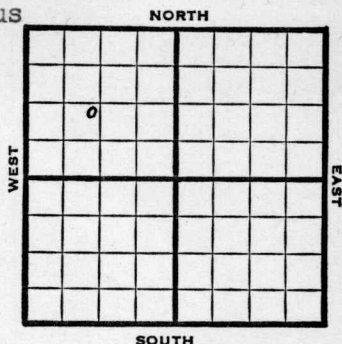

1947

Elev. 1361'

REPORT

11/5

10" @ 86

Drlg. 2000

11/12

Hunton 2336'

TD 2337'

5" @ 2336'

11/19

TD 2340 - 1300' oil 10 hrs.

11/25

"

12/3

Hunton 2336'

5" @ 2336'

Pump 79 oil & 29 W Pot

Gr. 38°

Total Depth 2340'

COMPLETED

Form 26 200 Bks. 10-46 Petrol
KansasMap No. _____ Sec. 17 Twp. 23 R. 4EWell No. 30 Lathrop

Cities Service _____ Company

FIRST REPORT

Contractor _____

C N L S $\frac{1}{2}$ NW

SECTION PLAT

03			

_____ Ft. from N. Line

840 Ft. from S. Line

_____ Ft. from E. Line

1220 Ft. from W. Line

Butler County

Location _____

Rig up _____

Drilling and Remarks:

10" @ 86

drlg. 2000

RECORD

Cased _____ in., _____ ft.

Sand _____

Gas _____

Oil _____

Total Depth _____

PRODUCTION

1st 24 hrs. Nat. _____

1st 24 hrs. after shot _____

Gas _____ Cu. Ft.

Dry Hole _____

Abandoned _____

Date

NOV 5 1947 19

S. J. LEWIS Scout

Map No. 14 Sec. 17 Twp. 23 R. 4E

Well No. 30 Lathrop

Cities Service Company

COMPLETE Contractor

C N L S $\frac{1}{2}$ NW

E 1/36/
SECTION PLAT

 Ft. from N. Line

840 Ft. from S. Line

 Ft. from E. Line

1220 Ft. from W. Line

Butler County

Location

Rig up

Drilling and Remarks:

New hole 336

5" C 2336

*Prod 79 oil +
29 W Bx*

38% SW

RECORD

Cased in., ft.

Sand

Gas

Oil

Total Depth 2340

PRODUCTION

1st 24 hrs. Nat.

1st 24 hrs. after shot

Gas Cu. Ft.

Dry Hole

Abandoned

Date

DEC 3 1947 19

S. J. LEWIS

Scout