


LOCATION NOTICE

TULSA, OKLA., May 25, 1951WELL NO. 6 ON Viola M. Griblin "B" FARM

WILL BE AS FOLLOWS:

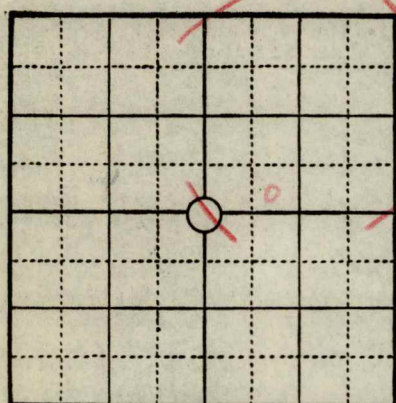

..... FEET FROM NORTH LINE

..... FEET FROM EAST LINE

330

..... FEET FROM SOUTH LINE

990

..... FEET FROM WEST LINE

IN NE 1/4 SEC. 21 TWP. 23S RANGE 13EGreenwoodKansas

..... COUNTY, STATE OF

REMARKS: R. L. Mankey ----- Dist. Supt.B. F. Williams ----- ForemanM.C.P.C. ----- 100%

SIGNED

A. E. Pierce*W*

COPIES TO

R. W. McDOWELL
 DISTRICT SUPT.
 ACCOUNTING DEPT.
 SCOUTING DEPT.
 GEOLOGICAL DEPT.
 PIPE LINE DEPT.
 MATERIALS DEPT.
 RENTAL DEPT.
 LEGAL DEPT.
 LEO MEYER
 INCOME TAX DEPT.
 ENGINEERING DEPT.
 LEASE INVENTORY
 CLAIM DEPT.
 J. W. BASORE
 FILE

*9**Card
JGM*