


Section 17 Township 23 Range 4-E

Well No. #34 Lathrop

Company Cities Service

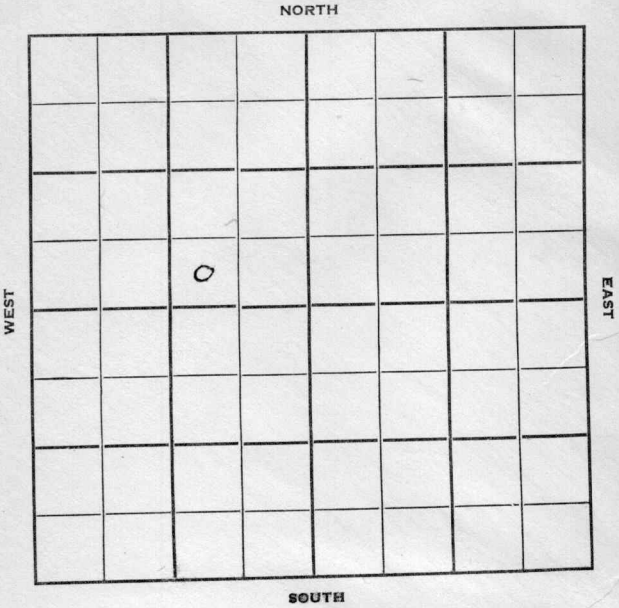

Sec. 17 Twp. 23 R. 4-E ✓

Well No. #34 Lathrop Farm

Cities Service Company

B & R Drlg. Contractor


 Ft. from N. Line

330 Ft. from S. Line

990 Ft. from E. Line

 Ft. from W. Line

SW SE NW

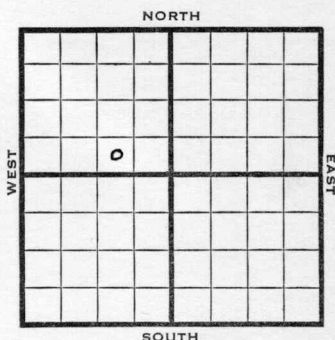

1950

Elev 1369

REPORT

7/12

10" @ 78

Drlg 340

8/9

10" @ 78

Lans 1753

Heeb 2338

Viola 2406

Sd 2427

TD 2490

7" @ 2489

40/2408-18

860' oil 1 hr 2400' oil 12 hr

Comp 100 bopd

Completed

KC 1966

Maq 2396

Dol 2416-27

Arb 2484

COMPLETED

Map No. _____ Sec. 17 Twp. 23 R. 4EWell No. 34 Lathrop

_____ Cities Service _____ Company

_____ B & R Drlg. _____ Contractor

SW SE NW

SECTION PLAT

	0		

_____ Ft. from N. Line

330 Ft. from S. Line990 Ft. from E. Line

_____ Ft. from W. Line

Butler County

Location _____

Rig up _____

Drilling and Remarks:

10" @ 78

drlg. 340

RECORD

Cased _____ in., _____ ft.

Sand _____

Gas _____

Oil _____

Total Depth _____

PRODUCTION

1st 24 hrs. Nat. _____

1st 24 hrs. after shot _____

Gas _____ Cu. Ft.

Dry Hole _____

Abandoned _____

Date

JUL 12 1950

19

J. E. TYRA Scout

Sec. 17 (Blk. Twp.) 23 (Sur. Rge.) 4E Map No.

Well No. 34 Farm Lathrop

Elev.	1369	Location	SW SE NW
-------	------	----------	----------

330 Ft. From S Line NW

990 Ft. From **E** Line Quarter

1st. Report

Completion **AUG 9 1950**

Remarks

Spudding Date _____

Drlg. Data

10" @ 78 Lans. 1753 KC 1966

Heeb. 2338 Maq. 2396 Viola 2406

Dol. 2416-27 Sd. 2427 Arb. 2484

TD 2490 7" @ 2489 40/ 2408-18

860' oil 1 hr. 2400' oil 12 hr.

Comp. 100 bopd

J. E. TYRA