


LOCATION NOTICE

TULSA, OKLA., August 7, 1951, 19.....

WELL NO. 8 ON V. M. Gribbin "B" FARM

WILL BE AS FOLLOWS:

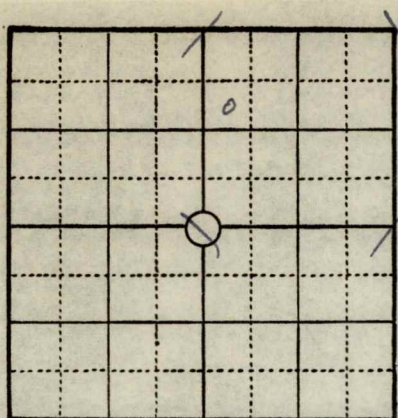

990..... FEET FROM NORTH LINE

..... FEET FROM EAST LINE

..... FEET FROM SOUTH LINE

330..... FEET FROM WEST LINE

IN NE 1/4 SEC. 21 TWP. 23S RANGE 13E

Greenwood COUNTY, STATE OF Kansas

REMARKS: R. L. Mankey -- Dist. Supt.

B. F. Williams -- Foreman

M. G. P. C. --- 100%

SIGNED A. E. Pierce

COPIES TO

R. W. McDOWELL
DISTRICT SUPT.
ACCOUNTING DEPT.
✓ SCOUTING DEPT.
GEOLOGICAL DEPT.
PIPE LINE DEPT.
MATERIALS DEPT.
RENTAL DEPT.
LEGAL DEPT.
LEO MEYER
INCOME TAX DEPT.
ENGINEERING DEPT.
LEASE INVENTORY
CLAIM DEPT.
J. W. BASORE
FILE

9 Card
JGM