


Section 17 Township 23 Range 4-E

Well No. #36 Lathrop

Company Cities Service

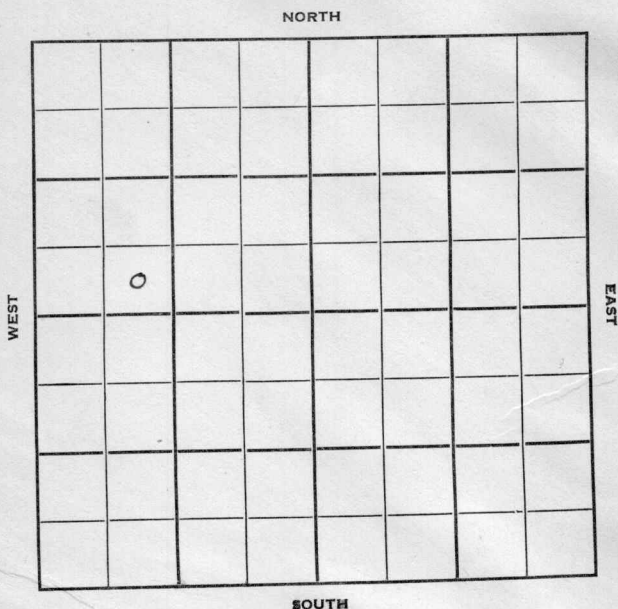

Butler KANSAS 4E

Sec. 17 Twp. 23 R. 4E

Well No. #36 Lathrop Farm

Cities Service

Company

Elbing Pool

O. W. D. D

Contractor

Ft. from N. Line

330'


Ft. from S. Line

Ft. from E. Line

990'

Ft. from W. Line

SE SW NW

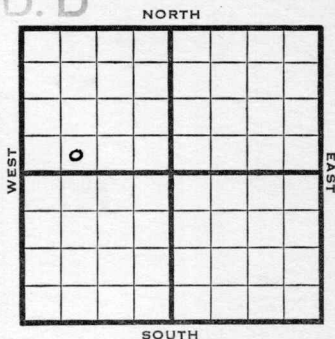

1950

Elev 1369'

REPORT

8/9

10" @ 86'

Drlg. 1325'

12/6

10" @ 86'

Viola 2449 Simp 2472

Arb 2532

TD 2540

7" @ 2539

36/2410-19

FU 2402' oil 2 hr

PB 2420

124/1970-2064 SSO

15/1978-93

54/2013-21

P/2 bo 38 bw 5 hr

TD 2540

D&A

ABANDONED

O. W. D. D

1951

1/10

SWD Well TD 3213

Arb. 2532 7" @ 2539

OTD 2540 D&A

DD Granite 3131'

TD 3213' Comp. for SWD

FIRST REPORT

COMPLETED

County **Butler** State **Kansas**

Sec. **17** (Blk.) **23** (Sur.) **4E** Map No.

Operator Cities Service

Well No. **36** Farm **Lathrop**

Elev.	1369	Location	SE SW NW
-------	------	----------	----------

[illegible]

330 Ft. From S Line NW

990	Ft. From	W	Line	Quarter
-----	----------	---	------	---------

1st. Report AUG 9 1950

Completion


Remarks

Spudding Date

Drlg. Data

10" @ 86 drlg. 1325

~~J. E. TYRA~~

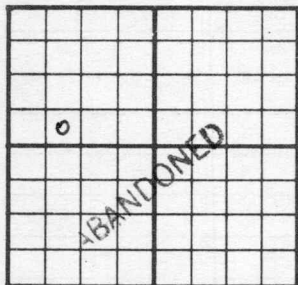County Butler State KansasSec. 17 (Blk. Twp.) 23 (Sur. Rge.) 4E Map No.Operator Cities ServiceWell No. 36 Farm LathropElev. 1369 Location SE SW NW330 Ft. From S Line NW990 Ft. From W Line Quarter


1st. Report

Completion DEC 6 1950Remarks Elbing Pool

Spudding Date

Drlg. Data D & A TD 254010" @ 86 Viola 2449 Simp. 2472Arb. 2532 TD 2540 7" @ 253936/ 2410-19 EU 2420' oil 2 hr.PB 2420 124/ 1970-2064 SSO 15/ 1978-8354/ 2013-21 P/ 2 bo 38 bw 5 hr.D & A

J. E. TYRA

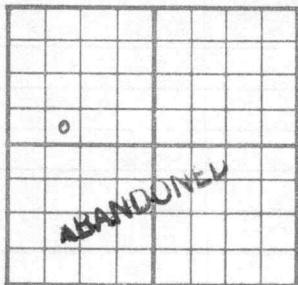County Butler State KansasSec. 17 (^{Blk.}_{Twp.}) 23 (^{Sur.}_{Rge.}) 4E Map No.Operator Cities ServiceWell No. 36 Farm LathropElev. 1369 Location SE SW NW330 Ft. From S Line NW990 Ft. From W Line Quarter1st. Report 8-9-50Completion 12-6-50Remarks Elbing Pool


Spudding Date

Drilg. Data D & A TD 254010" @ 86 Viola 2449 Simp. 2472Arb. 2532 TD 2540 7" @ 253936/ 2410-19 FU 2420' oil 2 hr. PB 2420124/ 1970-2064 SSO 15/ 1978-8354/ 2013-21 P/ 20 bo 38 bw 5 hr.D & A

Handwritten: Duplicate

J. E. TYRA


County **Butler** State **Kansas**
 Sec. **17** (Blk.) **23** (Sur.) **4E** Map No.
 Operator **Cities Service**
 Well No. **36** Farm **Lathrop**
 Elev. **1369** Location **SE SW NW**

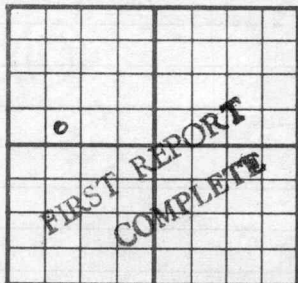

330 Ft. From **S** Line **NW**
990 Ft. From **W** Line Quarter
 1st. Report **JAN 1 0 1951**
 Completion **JAN 1 0 1951**
 Remarks **OWDD**
 Spudding Date

Drlg. Data **SWD well** **TD 3213**
Arb. 2532 7" @ 2539 OTD 2540 D & A
DD Granite 3131 TD 3213 Comp. for SWD

J. E. TYRA

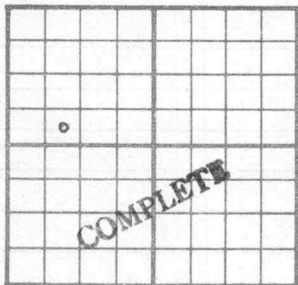County Butler State KansasSec. 17 (Blk.) 23 (Sur.) 4E Map No.Operator Cities ServiceWell No. 36 Farm LathropElev. 1369 Location SE SW NW330 Ft. From S Line NW990 Ft. From W Line Quarter1st. Report 1-10-51Completion 1-10-51Remarks OWDD

Spudding Date

Drlg. Data SWD well TD 3213Arb. 2532 7" @ 2539 OTD 2540 D & ADD Granite 3131 TD 3213 Comp. for SWDDuplicate

J. E. TYRA