


Section 17 Township 23 Range 4E

Well No. 38 Lathrop

Company Cities Service Oil

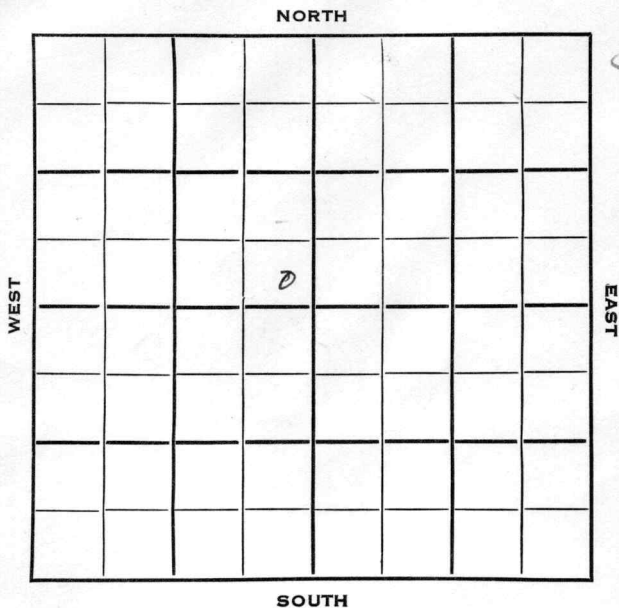

5

Butler

23


4E

Sec. 17 Twp. 23 R. 4EWell No. # 38 Lathrob FarmCities Service Oil Company

Contractor

 Ft. from N. Line200 Ft. from S. Line425 Ft. from E. Line Ft. from W. Line

SE SE NW

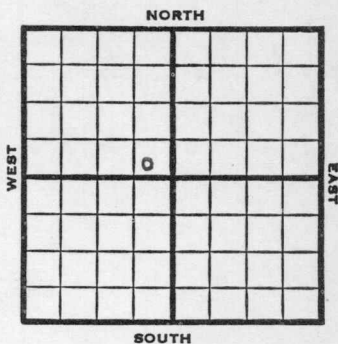

1953 Elev. 1365' REPORT

1/28 Spud 1-20-53
 10" @ 81
 Drlg. 2 319

2/18 Spud 1-20-53 Oil well TD 2327'
 10" @ 81 Lans. 1735' KC 1928
 B KC 2092' Hunton 2318
 TD 2320 7" @ 2319 DD 2327
 Comp. 34 BOPD 86 BW

COMPLETED

County **Butler** State **Kansas**

Sec. 17 (Blk. Twp.) 23 (Sur. Rge.) 4E Map No.

Operator Cities Service Oil

Well No. 38 Farm Lathrob

Elev.	1365	Location	SE SE NW
-------	------	----------	----------

200 Ft. From S Line NW

425 Ft. From E Line Quarter

1st. Report

Completion FEB 18 1953

Remarks

Spudding Date 1-20-53

Drilg. Data Oil well TD 2327

10" @ 81 Lans. 1735 KC 1928

B KC 2092 Hunton 2318 TD 2320

7" @ 2319 DD 2327 Comp. 34 bopd 86 bw

J. G. McGEHEE