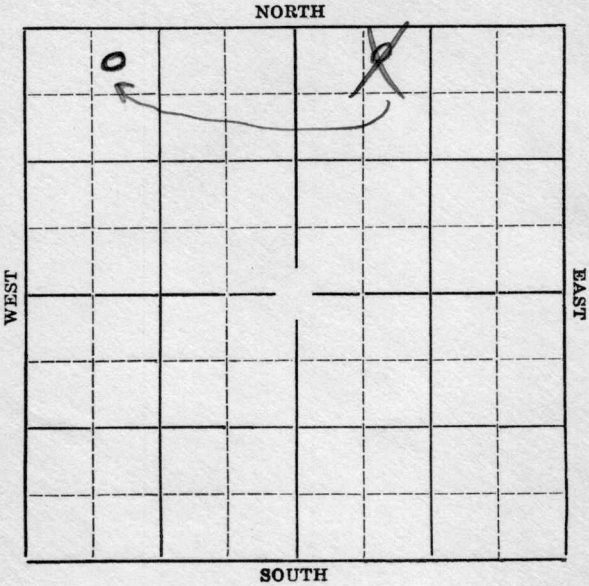


Section 17 Township 23 Range 4-EWell Number #13-North LathropCompany National Ref.

Map No. 14 Sec. 17 Twp. 23 R. 4EWell No. 13 North HathropNational Ref. Company

Contractor

SECTION PLAT

		0	

427 Ft. from N. Line

_____ Ft. from S. Line

_____ Ft. from E. Line

716 Ft. from W. Line

FIRST REPORT

Location _____

Rig up _____

Drilling and Remarks:

Wash

RECORD

Cased _____ in., _____ ft.

Sand _____

Gas _____

Oil _____

Total Depth _____

PRODUCTION

1st 24 hrs. Nat. _____

1st 24 hrs. after shot _____

Gas _____ Cu. Ft.

Dry Hole _____

Abandoned _____

Date

AUG 19 1936 19

S. J. LEWIS

Scout

KANSA

Map No. 14 Sec. 17 Twp. 23 R. 4E

Well No. 13 North Lathrop

National Ref. Company

Contractor

SECTION PLAT

0			

427 Ft. from N. Line

_____ Ft. from S. Line

_____ Ft. from E. Line

716 Ft. from W. Line

CORRECTION

Location _____

Rig up _____

Drilling and Remarks:

*Refracted in
NE/4*

RECORD

Cased _____ in., _____ ft.

Sand _____

Gas _____

Oil _____

Total Depth _____

PRODUCTION

1st 24 hrs. Nat. _____

1st 24 hrs. after shot _____

Gas _____ Cu. Ft.

Dry Hole _____

Abandoned _____

Date

SEP 30 1936

19

S. J. LEWIS

Scout

KANSAS

Map No. 14 Sec. 17 Twp. 23 R. 4E7Well No. 13 North LathropNational Ry. Company

Contractor

SECTION PLAT

0			

427 Ft. from N. Line

_____ Ft. from S. Line

_____ Ft. from E. Line

716 Ft. from W. Line

COMPLETED

Location _____

Rig up _____

Drilling and Remarks:

Kansas City
1862.
2000 acid
277 oil
and 100 water

RECORD

Cased _____ in., _____ ft.

Sand _____

Gas _____

Oil _____

Total Depth 2065

PRODUCTION

1st 24 hrs. Nat. _____

1st 24 hrs. after shot _____

Gas _____ Cu. Ft.

Dry Hole _____

Abandoned _____

Date

SEP 30 1936

19

S. J. LEWIS

Scout