


KANSAS

Section 17 Township 23 Range 4-E

Well No. #20 North Lathrop

Company CRA

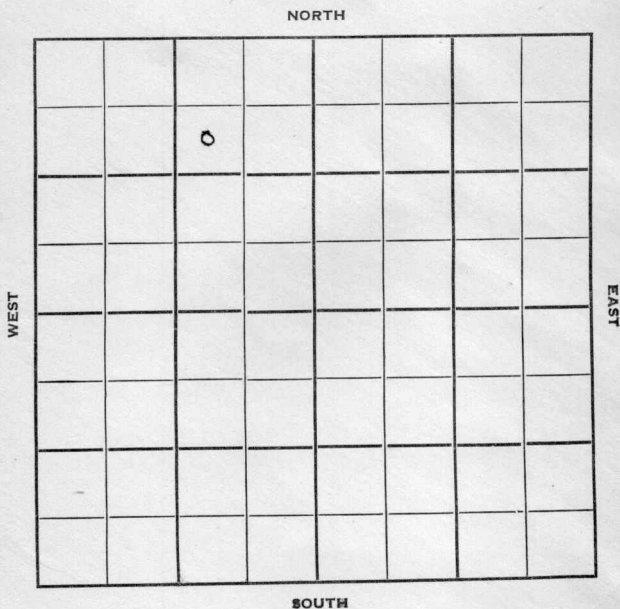

3

Butler

KANSAS

Sec. 17 Twp. 23 R. 4E

Well No. #20 North Lathrop Farm

CRA

Company

Contractor

Elbing Pool

990'

Ft. from N. Line


Ft. from S. Line

990'

Ft. from E. Line

Ft. from W. Line

SW NE NW

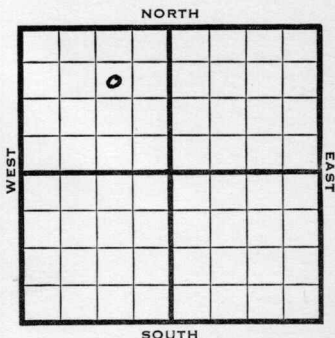

1950

Elev 1374

REPORT

8/16

RUR

9/6

Spud 8-15-50

8 5/8" @ 78

Lans 1746

KC 1948

Hunton 2343

DST 2349-54 op 15 min rec 290' oil

Viola 2423

TD 2427

5 1/2" @ 2424

FU 800' fluid in 20 min

Comp 100 bopd 22% wtr

Completed

COMPLETED

County Butler State KansasSec. 17 (Blk. Twp.) 23 (Sur. Rge.) 4E Map No. _____Operator C R AWell No. 20 Farm North LathropElev. _____ Location SW NE NW

990 Ft. From N Line NW990 Ft. From E Line Quarter1st. Report AUG 16 1950


Completion _____

Remarks _____

Spudding Date _____

Drlg. Data Elbing PoolRUR

J. E. TYRA

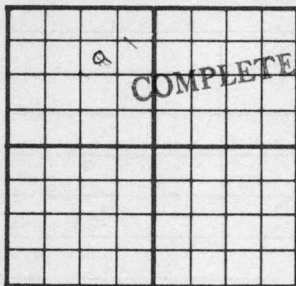County Butler State KansasSec. 17 (Blk.
Twp.) 23 (Sur.
Rge.) 4E Map No.Operator C R AWell No. 20 Farm North LathropElev. 1374 Location SW NE NW990 Ft. From N Line NW990 Ft. From E Line Quarter1st. ReportCompletion SEP 6 1950RemarksElbing PoolSpudding Date 8-15-50Drlg. Data Oil well TD 24278 5/8" @ 78 Lans. 1746 KC 1948Hunton 2343 DST 2349-54 open 15 min.Rec. 290' oil Viola 2423 TD 24275 1/2" @ 2424 FU 800' fluid in 20 min.Comp. 100 bopd 22% water

J. E. TYRA