

Location Notice

FORM 51 25M 8-50 WESTERN

Greenwood

KANSAS

Section 21 Township 23 S Range 13 E

Well No. # 8 V. M. Griblin "B"

Company M.C.P.C. --- 100%

NORTH

				0			

WEST

EAST

SOUTH

HOT FILE Greenwood **KANSAS** 23 13E

Sec. 21 Twp. 23 R. 13E

Well No. #8 V. M. Griblin "B" Farm

Mid-Continent Petr. Corp. Company

Jackman & Jackman - Contr. Contractor

Virgil Pool


990' Ft. from N. Line

Ft. from S. Line

Ft. from E. Line

330' Ft. from W. Line

SW NW NE

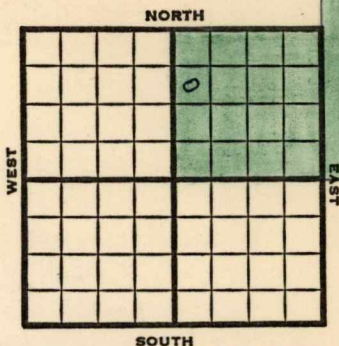

1951

Elev. --

REPORT

1800' Test

8/1	Location	(D R)
8/8	Moving in today.	"
8/9	MIT	"
8/10	Spudded 8-9-51, Set 10-3/4" 22' w/30 sax. TD 30	(Dr)
8/13	Drilling 1643'.	"
8/13	Drilling 1643'.	"
8/14	7" at 1699' with 75 sacks. Miss. 1697'	"
8/15	WOC.	"
8/16	WOC.	"
8/17	No report.	"
8/20	Moved in cable tools. Drilling 1710'.	"
8/22	Acidzed with 2000 gal. Running tubing.	"
8/23	Testing.	"
8/24	Testing.	"
8/27	Testing.	"
8/28	Comp. 8-28-51 - 10 bpd on pump.	"
9/10	Waiting on pumping equipment.	"
9/21	Waiting on pumping equipment.	"
9/27	Comp. for Est. 10 bopd.	"

OVER

1951

9/26

Spud 8-8-51

Oil well TD 1725' 10" @ 22


Miss 1697' 7" @ 1699 TD 1725'

2000 A

Comp. 10 BOPD

COMPLETED

County Greenwood State Kansas
 Sec. 21 (Blk. 23) (Sur. 13E) Map No.
 Operator Mid-Continent Petroleum Corp.
 Well No. 8 Farm V. M. Griblin "B"
 Elev. _____ Location SW NW NE

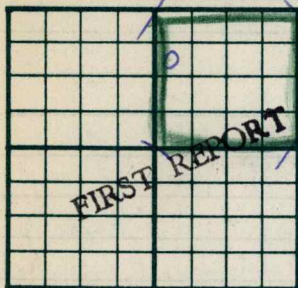

990 Ft. From N Line NE
330 Ft. From W Line Quarter
 1st. Report AUG 1 1951

Completion _____

Remarks _____

Jackman & Jackman - Contr.

Spudding Date _____

Drlg. Data _____

Virgil Pool

Location

J. E. TYRA

County	Greenwood		State	Kansas	
Sec.	21	(Blk. Twp.) 23	(Sur. Rge.) 13E	Map No.	
Operator	Mid-Continent Petroleum Corp.				
Well No.	8	Farm	V. M. Griblin "B"		
Elev.	Location		SW NW NE		
			990 Ft. From N Line NE		
			330 Ft. From W Line Quarter		
			1st. Report		
			Completion SFP 2 6 1951		
Remarks			Virgil Pool		
			Jackman & Jackman - Cont.		
Spudding Date			8-8-51		
Drlg. Data	Oil well		TD 1725		
10" @ 22	Miss. 1697		7" @ 1699	TD 1725	
2000 A	Comp. 10 bopd				

J. E. TYRA