


Form 51—5M—2-29—34703

Map No. **KANSAS** Sec. 22 Twp. 23 R. 13

Well No. 7 1/2 Sham Rock Farm

Company

NORTH

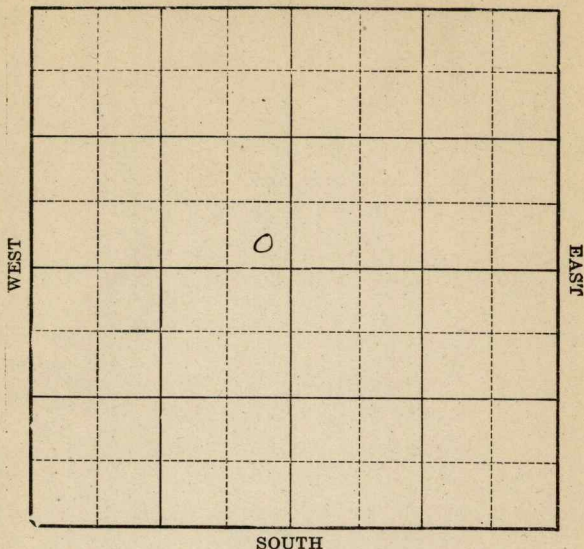

Location

Drilling Remarks

Rig Up

Drilling Remarks

RECORD

Cased _____ in. _____ ft.

Sand

Gas _____

Oil

Total Depth

PRODUCTION

1st 24 hrs. Nat.

1st 24 hrs. after shot

Gas _____ cu. ft.

Dry Hole

Abandoned

Map No. Kns Sec. 22 Twp. 23 R. 13

Well No. 1 Shambrugh
Kalco Oil Co Company

Contractor

FIRST REPORTS COMPLETED

SECTION PLAT

Ft. from N. Line

Ft. from S. Line

Ft. from E. Line

Ft. from W. Line

Location

Rig up

Drilling and Remarks:

100 Pbs

RECORD

Cased in, ft.

Sand 1542-1578

Gas

Oil

Total Depth 1578

PRODUCTION

1st 24 hrs. Nat.

1st 24 hrs. after shot

Gas Cu. Ft.

Dry Hole

Abandoned

Date

4/15/21

192

Sherwood

Scout