


Butler KANSAS

SECTION 17 TOWNSHIP 23 RANGE 4E

WELL NO. #28 South Lathrop

COMPANY CRA

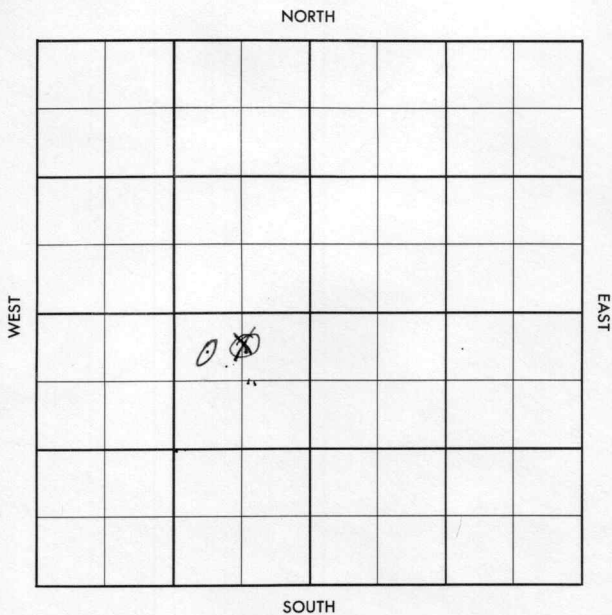

County Butler Elev. _____Sec. 17 Twp. 23 Rge. 4ECompany C R AFarm Name South Lathrop No. 28

TOPS	DEPTH	LOG	DATUM
Anh.			
Tp.			
H.			
Tr.			
Dg.			
Bl.			
L.			
K.C.			
B.K.C.			
Ce.			
C.			
M.			
M.			
K.			
Mz.			
Me.			
V.			
S.			
S.			
A.			
R.			
Pe.			
G.			
T.D.			

Loc. in Sec. _____

C N $\frac{1}{2}$ NE SW

Geol. _____

Contr. _____

Stearns Drlg

Pool _____

Elbing

FIRST REPORT	
DEC 12 '56	

Date Comm. 12-7-5613" @ 193/125 d rlg. 820

CORRECTION

FORM 513 SUNRAY

County	Butler	Elev.	1372
Sec.	17	Twp.	23
Company	C R A	Rge.	4E
Farm Name	South Lathrop	No.	28

TOPS	DEPTH	LOG	DATUM	Loc. in Sec.
Anh.				NE NE SW
Tr.				SWD well
H.				
Tr.				
Dg.				
Bl.				
L.				
K.C.				Geol.
B.K.C.				Contr.
Ce.				Stearns Drlg
C.				
M.				Pool
M. Hunt	2336			Elbing
K.				
Mz.				
Me.	2396			
V.	2412			
S. Dolo	2423			
S. sd	2436			
A.	2497			
R. sd	3031			
Pe.				
G.				
TD.	3039			

ABANDONED	
JAN 9 '57	

Date Comm. 12-7-56

13" @ 193/125 drlg. 820 DEC 19 '58

11 2030 DEC 26 '58 DST 2437-58 1hr

15' Md (SSO) BHP 640/20

11 2510 JAN 2 '57 85% 2547/1550

11 2887 JAN 9 '57 12 1/2 CO 3039 INPUT

120 BW capacity of 13,200

Bwpd comp. SWD well