Butler


FORM 51 25M 8-50 WESTERN

KANSAS

Section 1 Township 26 Range 4E

Well No. #64 Porter

Company Allbe Oil

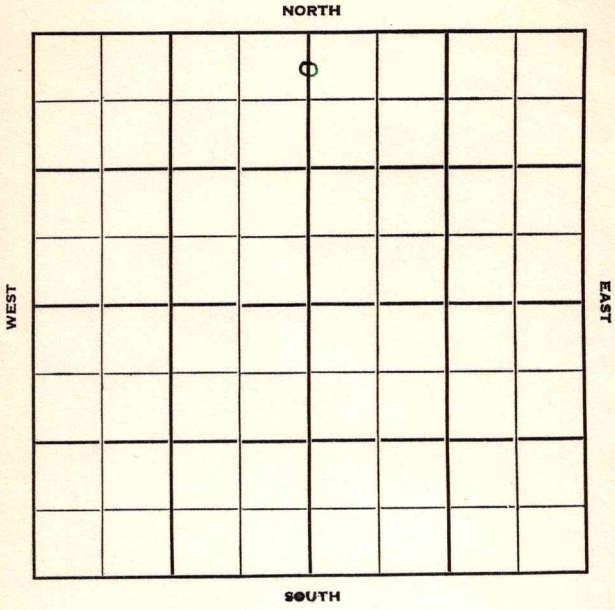

FORM 252-B
10M 8-51 TPCO.

Butler KANSAS

Sec. 1 Twp. 26 R. 4 E

Well No. # 64 Porter Farm

Allbe Oil Company

White & Ellis Contractor


330 Ft. from N. Line

Ft. from S. Line

2640 Ft. from E. Line

Ft. from W. Line

C N/2 N/2 of Sec.

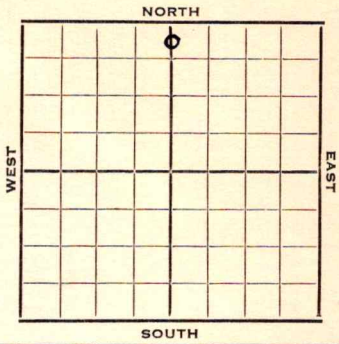

1951	Elev. 1406' REPORT
11/28	Spud 11-25-51 10" @ 80 Drlg. 1120'
12/12	Spud 11-25-51 Oil Well TD 2433 10" @ 80 Arb. 2423 5" @ 2423 TD 2433 FU 300' oil 8 hr. Comp. 20 BOPD

COMPLETED

FORM 275 FOR SALE BY KANSAS BLUE PRINT CO.

County Butler State Kansas

Sec. 1 (Blk. / Twp.) 26 (Sur. / Rge.) 4E Map No.

Operator Allbe Oil

Well No. 64 Farm Porter

Elev. Location C N/2 N/2 Of Sec.



330 Ft. From N Line

2640 Ft. From E Line Quarter

1st. Report NOV 28 1951

Completion

Remarks

White & Ellis - Contr.

Spudding Date 11-25-51

Drlg. Data

10" @ 80 Drlg. 1120

J. E. TYRA

FORM 275 FOR SALE BY KANSAS BLUE PRINT CO.


County Butler State Kansas

Sec. 1 (Blk. Twp.) 26 (Sur. Rge.) 4E Map No.

Operator Allbe Oil

Well No. 64 Farm Porter

Elev. 1406 Location C N/2 N/2 Sec.

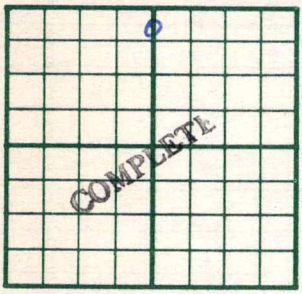

330 Ft. From N Line Sec.

2640 Ft. From E Line Quarter

1st. Report

Completion DEC 1 2 1951

Remarks

White & Ellis - Contr.

Spudding Date 11-25-51

Drlg. Data Oil well TD 2433

10" @ 80 Arb. 2423 5" @ 2423

TD 2433 FU 300' oil 8 hr.

Comp. 20 bopd

J. E. TYRA