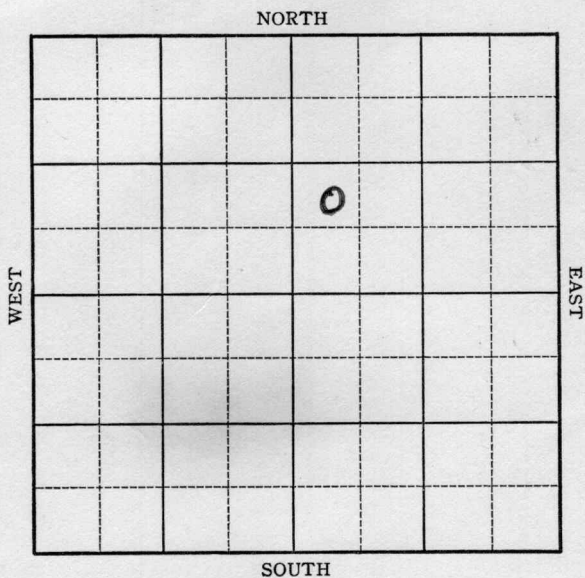


Section 17 Township 23 Range 4-EWell No. 17 - ScullyCompany Phillips

1937

8/18 8" @ 1733'.

K.C. 2023'.

T.D. 2072'.

1000 acid.

Pot. 267 oil & 183 water.

COMPLETED

Butler

KANSAS

Map No. 14 Sec. 17 Twp. 23 R. 4EWell No. 17 - ScullyPhillips Company

Contractor

FIRST REPORT

SECTION PLAT

		0	

 Ft. from N. Line920 Ft. from S. Line Ft. from E. Line400 Ft. from W. LineLocation ✓Rig up

Drilling and Remarks:

RECORD

Cased in., ft.Sand Gas Oil Total Depth

PRODUCTION

1st 24 hrs. Nat. 1st 24 hrs. after shot Gas Cu. Ft.Dry Hole Abandoned

Date

JUN 2 1937 19

H. D. Hatfield

Scout

Butler KANSAS

Map No. 14 Sec. 17 Twp. 23 R. 4^EWell No. 17 - ScullyPhillips Company

Contractor

COMPLETED

SECTION PLAT

		0	

 Ft. from N. Line920 Ft. from S. Line Ft. from E. Line400 Ft. from W. LineLocation Rig up

Drilling and Remarks:

1000 acidPat - 267 oil183 wat

RECORD

Cased 8 in., 1733 ft.Sand K.C. 2023Gas Oil Total Depth 2072

PRODUCTION

1st 24 hrs. Nat. 1st 24 hrs. after shot Gas Cu. Ft.Dry Hole Abandoned

Date

AUG 18 1937H. D. Hatfield

Scout