


Section 17 Township 23 Range 4-E

Well No. #20 Scully

Company Phillips Pet.

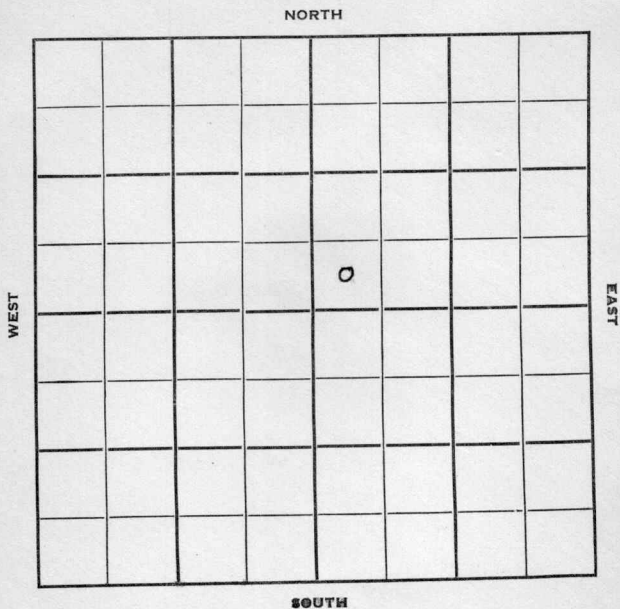

Butler

KANSAS

17

23

4E ✓

Sec. _____ Twp. _____ R. _____

Well No. #20 Scully Farm _____

Phillips Pet. Company _____

Contractor _____

_____ Ft. from N. Line

330'


_____ Ft. from S. Line

_____ Ft. from E. Line

330'

_____ Ft. from W. Line

SW SW NE

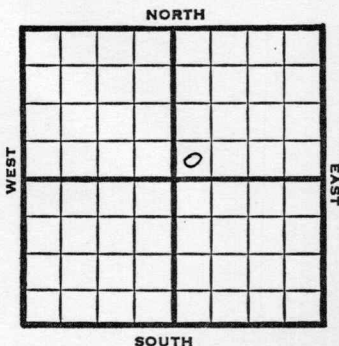

1950

Elev. 1371' REPORT

5/17

Spud 5-11-50

10" @ 219'

Drlg. 1801'

6/7

10" @ 219'

Lans. 1736'

KC 1940'

BKC 2118'

Hunton 2304'

Viola 2388'

Simp 2412'

Arb 2472'

7" @ 2475'

CO to 2432

Perf 44/2401-12

Perf 40/2388-98

P 100 BOPD

TD 2550'

COMPLETED

Kansas

Map No. _____ Sec. 17 Twp. 23 R. 4EWell No. 20 ScullyPhillips Pet. Company

Contractor

SW SW NE

SECTION PLAT

_____ Ft. from N. Line

330 Ft. from S. Line

_____ Ft. from E. Line

330 Ft. from W. Line

		o	
FIRST REPORT			

Butler

Location _____

Rig up _____

Drilling and Remarks:

Spud. 5-11-50

10" @ 219

Drlg. 1801

RECORD

Cased _____ in., _____ ft.

Sand _____

Gas _____

Oil _____

Total Depth _____

PRODUCTION

1st 24 hrs. Nat. _____

1st 24 hrs. after shot _____

Gas _____ Cu. Ft.

Dry Hole _____

Abandoned _____

Date

MAY 17 1950

19

J. E. TYRA

Scout

Kansas


Map No. _____ Sec. 17 Twp. 23 R. 4EWell No. 20 ScullyPhillips Pet. Company

Contractor

SW SW NE

E1.1371

SECTION PLAT

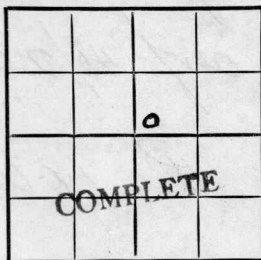

_____ Ft. from N. Line

330 Ft. from S. Line

_____ Ft. from E. Line

330 Ft. from W. Line

Butler

Location _____

Rig up _____

Drilling and Remarks:

10" @ 219Lans 1736KC 1940BKC 2118Hunter 2304Viola 2388Simp 2412

Date

RECORD

Cased _____ in., _____ ft.

Sand _____

Gas _____

Oil _____

Total Depth 2550

PRODUCTION

1st 24 hrs. Nat. _____

1st 24 hrs. after shot _____

Gas _____ Cu. Ft.

Dry Hole _____

Abandoned _____

(over)

JUN 7 1950 19

J. E. TYRA Scout

Arb 2472

7" @ 2475

Claw out to 2432

perf 44/2401-12

perf 40/2388-98

P 100 BOPD.

Scout Cards
 Land Small Map
 Land Wall Map
 Trainers
 France Map
 Pierce Map
 Misc. Abandoned

JUN 15 1950