


Map No. 15-Butler Sec. 17 Twp. 23 R. 4E
 Well No. Phillips Farm _____ Company _____

NORTH

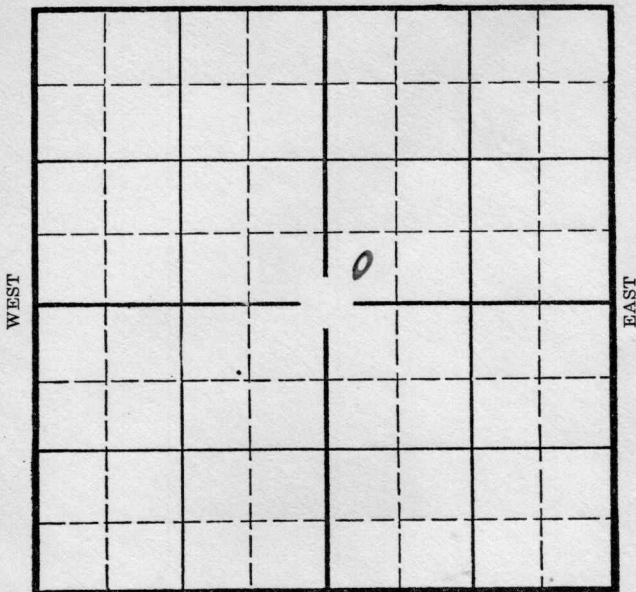

SOUTH

Location _____
 Drilling Remarks _____

Rig Up _____
 Drilling Remarks _____

RECORD

Cased _____ in. _____ ft.
 Sand _____
 Gas _____
 Oil _____
 Total Depth _____

PRODUCTION

1st 24 hrs. Nat. _____
 1st 24 hrs. after shot _____
 Gas _____ cu. ft. _____
 Dry Hole _____
 Abandoned _____

Butler

KANSAS

Map No. _____ Sec. 17 Twp. 23 R. 4E

Well No. 15- Scully Farm _____

Phillips Pet

Company _____

NORTH

			0		

WEST

EAST

SOUTH

2420 Ft. from N. Line

_____ Ft. from S. Line

_____ Ft. from E. Line

400 Ft. from W. Line

Elev. 1369

Date

REPORT

12/30 Location
1/10/36
1/17 20" 39
1/24 " 885 15" 175
1/31 " 1180 12" 1141
2/7 10" 1735 20" plug
2/14 TIC C 1906 8" 1968
20 1991-95 Pay 2030-39
TD 2045 2039
1000' oil & 100' wtr
pumped 182 oil & 52 wtr 2 hrs
2/21 SD
2/28 pumped 78 oil & 18 wtr
8" 2030 20" plug
3/6 56 oil 12 hrs 1000 acid
3/11 IC C 1906
TD 2045
1000 acid
312 Bbls.

COMPLETED

Map No. 14 Sec. 17 Twp. 23 R. 4 E

Well No. 15-Scully

Phillips pet Company

Contractor

FIRST REPORTS

SECTION PLAT

2420 Ft. from N. Line

..... Ft. from S. Line

..... Ft. from E. Line

400 Ft. from W. Line

		0	

Location ✓

Rig up

Drilling and Remarks:

RECORD

Cased.....in.,ft.

Sand

Gas

Oil

Total Depth

PRODUCTION

1st 24 hrs. Nat.....

1st 24 hrs. after shot.....

Gas.....Cu. Ft.

Dry Hole

Abandoned

Date

12-30-35 192.....

ORVAL MANN SCHRECK

Scout

Map No. 14 Sec. 17 Twp. 23 R. 4E

Well No. 15- Scully

Phillips Petroleum Company

Contractor

COMPLETE

SECTION PLAT

2420 Ft. from N. Line

..... Ft. from S. Line

..... Ft. from E. Line

400 Ft. from W. Line

		0	

Location.....

Rig up.....

Drilling and Remarks:

1000 acid

312 bbls

RECORD

Cased..... in.,..... ft.

Seal RC 1906

Gas.....

Oil.....

Total Depth 2045

PRODUCTION

1st 24 hrs. Nat.....

1st 24 hrs. after shot.....

Gas..... Cu. Ft.

Dry Hole.....

Abandoned.....

Date

3-11-36 192.....

ORVAL MANNSCHRECK
Scout