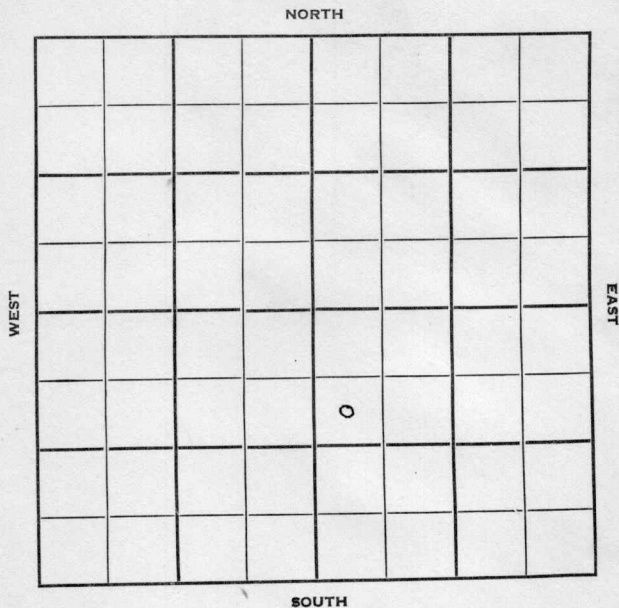


Section 17 Township 23 Range 4-EWell No. #21 ScullyCompany Phillips Pet.

Butler KANSAS
23 4E

Sec. 17 Twp. R.

Well No. #21 Scully Farm

Phillips Pet. Company

Contractor


990' Ft. from N. Line

Ft. from S. Line

Ft. from E. Line

330' Ft. from W. Line

SW NW SE

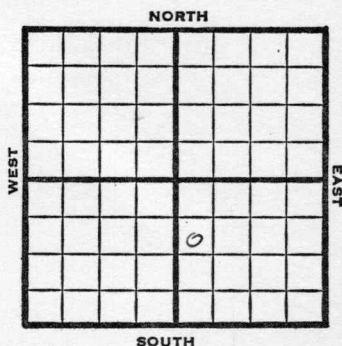

1950

Elev 1366

REPORT

5/24

Rig up

6/14

10" @ 218

Lans 1723

KC 1938

Kinderhook 2291

Hunton 2323

Maq. 2384

Viola 2406

Simp 2433

Arb. 2493

TD 2497

7" @ 2491

8/2411013

FU 80' oil in 15 min

S/ 4 bo 10 min

20/2404-09

FU 320' oil in 15 min

S/ 21 boph

S/ 35 boph

S/ 115 bo 2 hr

Comp. 100 bopd

Completed

COMPLETED

Map No. _____ Sec. 17 Twp. 23 R. 4EWell No. 21 ScullyPhillips Pet. Company_____
Contractor

SW NW SE

SECTION PLAT

990 Ft. from N. Line

_____ Ft. from S. Line

_____ Ft. from E. Line

330 Ft. from W. Line

		0	
FIRST	REPORT		

Butler

Location _____

Rig up X

Drilling and Remarks:

RECORD

Cased _____ in., _____ ft.

Sand _____

Gas _____

Oil _____

Total Depth _____

PRODUCTION

1st 24 hrs. Nat. _____

1st 24 hrs. after shot _____

Gas _____ Cu. Ft.

Dry Hole _____

Abandoned _____

Date

MAY 24 1950

19

J. E. TYRA Scout

Kansas

Map No. _____ Sec. 17 Twp. 23 R. 4EWell No. 21 Scully

_____ Phillips Pet. _____ Company


_____ Contractor

SW NW SE

El. 1366
SECTION PLAT990 Ft. from N. Line

_____ Ft. from S. Line

_____ Ft. from E. Line

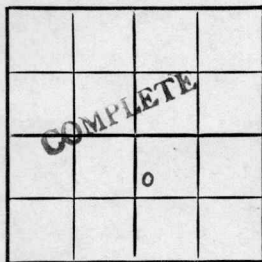330 Ft. from W. Line

Butler County

Location _____

Rig up _____

Drilling and Remarks:

10" @ 218

Lens. 1723

KC 1938

Kinderhook 2291

Hunton 2323

Maq. 2384

Viola 2406

Simp. 2433

RECORD

Cased _____ in., _____ ft.

Sand _____

Gas _____

Oil _____

Total Depth _____

PRODUCTION

1st 24 hrs. Nat. _____

1st 24 hrs. after shot _____

Gas _____ Cu. Ft.

Dry Hole _____

Abandoned _____

Date

JUN 14 1939J. E. TYRA Scout

Arb. 2493 18

TD 2497

7" @ 2491

8/ 2411-13

FU 80' oil in 15 min.

S/ 4 bo 10 min.

20/ 2404-09

FU 320' oil in 15 min. PRODUCTION

S/ 21 boph

S/ 35 boph

S/ 115 bo 2 hr.

Comp. 100 bopd

Misc.
Pierce Map
France Map
Tracings
Land Wall Map
Land Small Map
Scout Cards

7 M

Oil
Gas
Sand
Gravel

RECORD



SECTION 16.41

COMPASS

COMPASS

Map No. 37 1911A

Map No. 300 1911A

Form 30 300-1911A 11-40 1911A