


Section 17 Township 23 Range 4-E

Well No. #24 Scully

Company Phillips Pet.

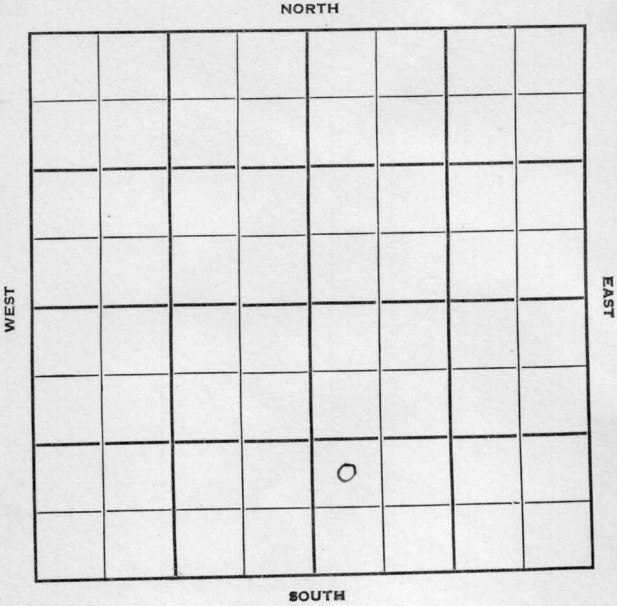

KANSAS

Butler

Sec. 17 Twp. 23 R. 4-E ✓

Well No. #24 Scully Farm

Phillips Pet.

Company

B & R Drlg.

Contractor

Miscellaneous

Ft. from N. Line

990


Ft. from S. Line

Ft. from E. Line

330

Ft. from W. Line

NW SW SE

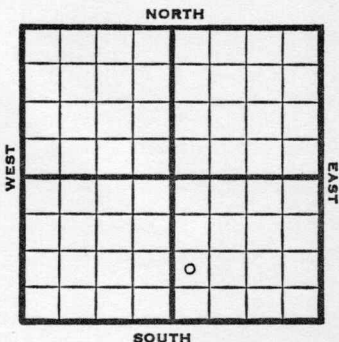

1950

Elev 1363

REPORT

8/2

Rig Up

9/13

Spud 8-2-50

Oil Well TD 2427'

10" @ 1022'

Hunton 2344' Maq 2395'

Viola 2424'

DST 2424-27 opn $\frac{1}{2}$ hr.

Rec. 670' oil 30' hocm 7" @ 2425'

TD 2427' FU 1800' fluid $8\frac{1}{2}$ hr.

S/ $13\frac{1}{2}$ BOPH S/ $11\frac{1}{2}$ BOPH

Comp. 104 BOPD 24 BWPD

COMPLETED

Kansas

Map No. _____ Sec. 17 Twp. 23 R. 4EWell No. 24 Scully

_____ Phillips Pet. _____ Company

_____ B & R Drlg. _____ Contractor

NW SW SE

E1. 1363
SECTION PLAT

_____ Ft. from N. Line

990 Ft. from S. Line

_____ Ft. from E. Line

330 Ft. from W. Line

Butler County

Location _____

Rig up X

Drilling and Remarks:

RECORD

Cased _____ in., _____ ft.

Sand _____

Gas _____

Oil _____

Total Depth _____

PRODUCTION

1st 24 hrs. Nat. _____

1st 24 hrs. after shot _____


Gas _____ Cu. Ft.

Dry Hole _____

Abandoned _____

Date

AUG 2 1950 19 J. E. TYRA Scout

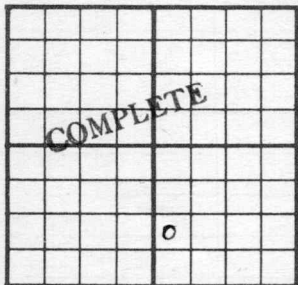County Butler State KansasSec. 17 (^{Blk.}_{Twp.}) 23 (^{Sur.}_{Rge.}) 4E Map No.Operator Phillips PetroleumWell No. 24 Farm ScullyElev. 1363 Location NW SW SE990 Ft. From S Line SE330 Ft. From W Line Quarter

1st. Report

Completion SEP 13 1950

Remarks

MiscellaneousSpudding Date 8-2-50Drlg. Data Oil well TD 242710" @ 1022 Hunton 2344 Maq. 2395Viola 2424 DST. 2424-27 open $\frac{1}{2}$ hr.Rec. 670' oil 30' hoem 7" @ 2425TD 2427 FU 1800' fluid $8\frac{1}{2}$ hr.S/ $13\frac{1}{2}$ boph S/ $11\frac{1}{2}$ bophComp. 104 bopd 24 bwpd

J. E. TYRA