


Section 17 Township 23 Range 4E

Well No. #27 Scully

Company Phillips Pet.

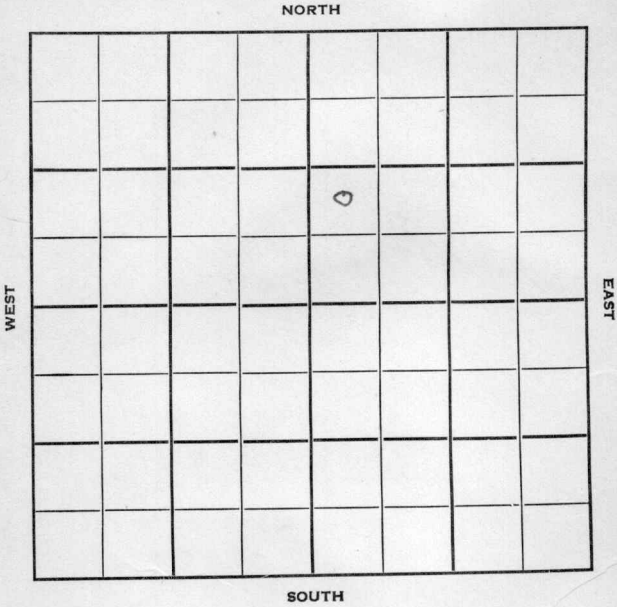

Butler KANSAS

Sec. 17 Twp. 23 R. 4 E

Well No. # 27 Scully Farm

Phillips Pet.

Company

Contractor

1550

Ft. from N. Line


Ft. from S. Line

Ft. from E. Line

330

Ft. from W. Line

NW SW NE

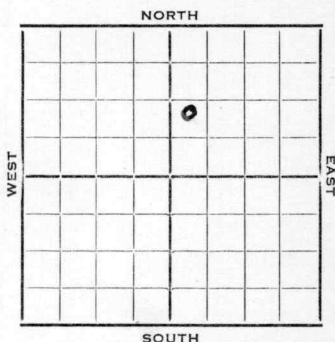

1952 Elev. 1385' REPORT


11/5 Location

1953
1/14

Spud 11-16-52
Oil Well TD 2385
Lans 1768, B KC 2154, Hunton
2359,
TD 2364
7" @ 2360
CO to 2364
DD 2368 S/22 bo 6 bw 1 hr.
DD 2377 S/115 bo 72 bw 7 hrs.
DD 2385 S/28 bo 97 bw
S/4 bo 58 bw 2 hrs.
Comp. 60 bopd 1378 bw

COMPLETED

County Butler State Kansas
 Sec. 17 (Blk. 23 (Sur. 4E Map No. (Twp.) Rge.)
 Operator Phillips Pet.
 Well No. 27 Farm Scully
 Elev. 1385 Location NW SW NE

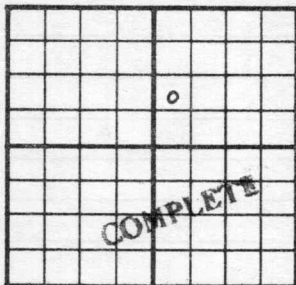

1550 Ft. From N Line NE

330 Ft. From W Line Quarter

1st. Report

Completion JAN 14 1953

Remarks

Spudding Date 11-16-52

Drlg. Data Oil well TD 2385

Lans. 1768 B KC 2154 Hunton 2359

TD 2364 7" @ 2360 CO to 2364

DD 2368 S/ 22 bo 6 bw 1 hr. DD 2377

S/ 115 bo 72 bw 7 hr. DD 2385

S/ 28 bo 97 bw S/ 4 bo 58 bw 2 hr.

Comp. 60 bopd 1378 bw

J. G. McGEHEE