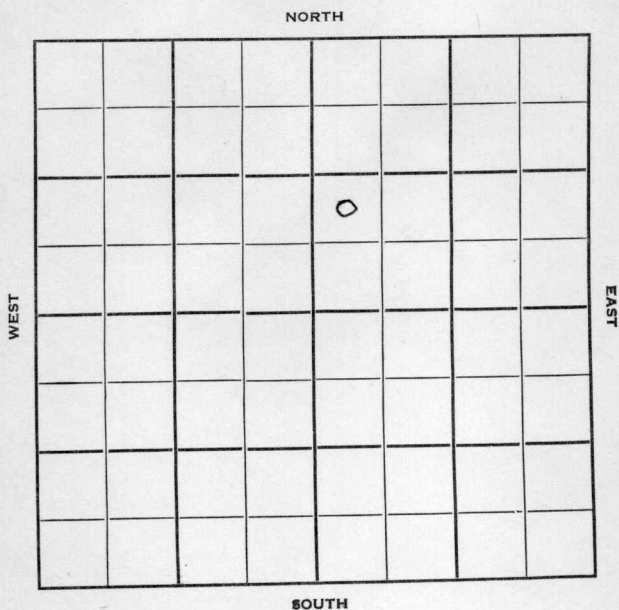


Section 17 Township 23 Range 4EWell No. #22 ScullyCompany Phillips

KANSAS

Butler ✓

Sec. 17 Twp. 23 R. 4-E

Well No. #22 Scully Farm

Phillips Pet. Company

Contractor


 Ft. from N. Line

990 Ft. from S. Line

 Ft. from E. Line

330 Ft. from W. Line

NW SW NE

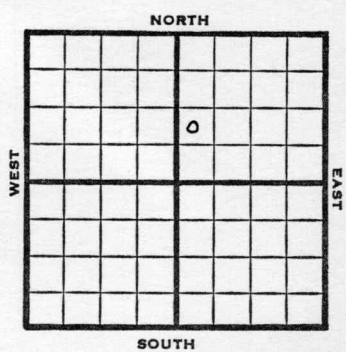

1950

Elev 1382

REPORT

6/7

Spud 6-4-50
10" @ 218
W.O.C.

6/21

10" @ 218'
Kinderhook 2317'
Hunton 2343'
Maq. 2404
Viola 2425'
Simp. 2453'
Arb. 2517-17½ TD
7" @ 2516'
PB 2473'
18/2435-32
F 350' oil 2 hrs.
S/35 BOPH
2/2433-34
20/2437-42
S/135 BO 2 hrs.
HFO 4 hrs.
S/127 BO 2 hrs.
Comp. 100 BOPD
TD 2517½'

COMPLETED

Kansas

Map No. _____ Sec. 17 Twp. 23 R. 4EWell No. 22 ScullyPhillips Pet. Company

Contractor

NW SWNE

El. 1382

SECTION PLAT

_____ Ft. from N. Line

990 Ft. from S. Line

_____ Ft. from E. Line

330 Ft. from W. Line

		0	
FIRST		REPORT	

Butler

Location _____

Rig up _____

Drilling and Remarks:

Spud 6-4-50

10" @ 218

W. O. C.

RECORD

Cased _____ in., _____ ft.

Sand _____

Gas _____

Oil _____

Total Depth _____

PRODUCTION

1st 24 hrs. Nat. _____

1st 24 hrs. after shot _____

Gas _____ Cu. Ft.

Dry Hole _____

Abandoned _____

Date

JUN 7 1950J. E. TYRA Scout

Kansas

Map No. _____ Sec. 17 Twp. 23 R. 4EWell No. 22 Scully

Phillips Petroleum

Company

Contractor

NW SW NE

El. 1383

SECTION PLAT

_____ Ft. from N. Line

990 Ft. from S. Line

_____ Ft. from E. Line

330 Ft. from W. Line

		0	

COMPLETE

Butler County

Location _____

Rig up _____

Drilling and Remarks:

10" @ 218

Kinderhook 2317

Hunton 2343

Maq. 2404

Viola 2425

Simp 2453

Arb. 2517-17 $\frac{1}{2}$ TD

RECORD

Cased _____ in., _____ ft.

Sand _____

Gas _____

Oil _____

Total Depth 2517 $\frac{1}{2}$

PRODUCTION

1st 24 hrs. Nat. _____

1st 24 hrs. after shot _____

Gas _____ Cu. Ft.

Dry Hole _____

Abandoned _____

Date

JUN 21 1950 19

J. E. TYRA Scout

18

De

DE

.....

DLA 4076

2187

10

[Handwritten signature]

14


[Handwritten signature]

10/1/80

2999

9829

RECORD

[illegible]


MSU 140

1956-1957

FORM NO. 103-BK-11-40-15101