


Section 17 Township 23 Range 4-E
Well No. #23 Scully
Company Phillips Pet.

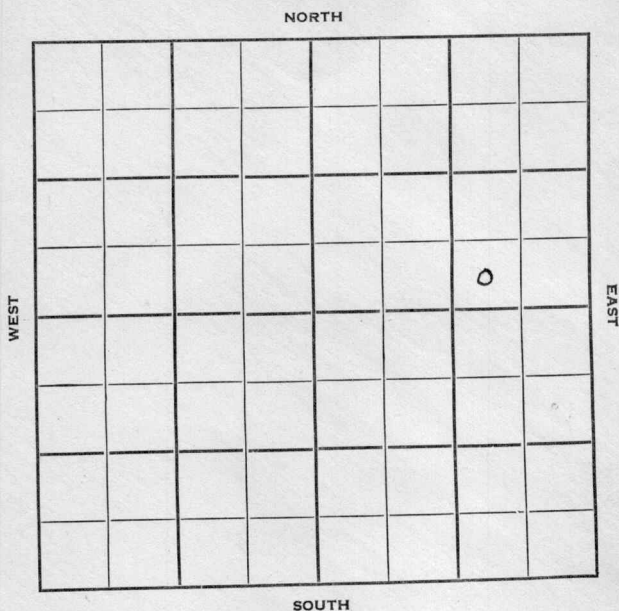

Butler

KANSAS

Sec. 17 Twp. 23 R. 4E

Well No. #23 Scully Farm

Phillips Pet. Company

Miscellaneous Contractor


Ft. from N. Line

330' Ft. from S. Line

990' Ft. from E. Line

Ft. from W. Line

SW SE NE

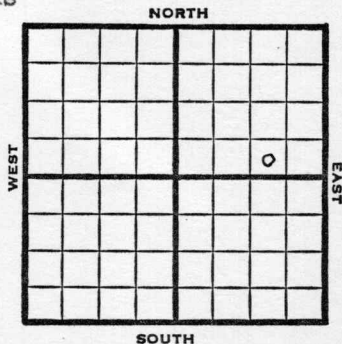

1950	REPORT	
	Elev 1393	
6/21	Spud 6-17-50	
	10-3/4" @ 250'	
	Drlg. 1282'	
8/2	10 3/4" @ 250	
	Lans 1821	KC 2040
	B KC 2220	Cong 2392
	Hunton 2457	
	DST 2458-67, rec SW	
	Maq 2520	Viola 2566
	Br dol 2594	Simp sd 2623
	Arb 2758	Regan 3522
	Granite 3572	
	TD. 3585	
	7" @ 2766	
	1000 A	
	Comp/ for SWD Input 358 bw	
	Completed	
	COMPLETED	

Map No. _____ Sec. 17 Twp. 23 R. 4EWell No. 23 ScullyPhillips Pet.

Company

Contractor

SW SE NE

SECTION PLAT

_____ Ft. from N. Line

330 Ft. from S. Line990 Ft. from E. Line

_____ Ft. from W. Line

Butler County

Location _____

Rig up _____

Drilling and Remarks:

Spud 6-17-50

10 3/4" @ 250

drlg. 1282

RECORD

Cased _____ in., _____ ft.

Sand _____

Gas _____

Oil _____

Total Depth _____

PRODUCTION

1st 24 hrs. Nat. _____

1st 24 hrs. after shot _____

Gas _____ Cu. Ft.

Dry Hole _____

Abandoned _____

Date

JUN 21 1950 19J. E. TYRA Scout

County Butler State KansasSec. 17 (^{Blk.}_{Twp.}) 23 (^{Sur.}_{Rge.}) 4E Map No.Operator Phillips PetroleumWell No. 23 Farm ScullyElev. 1393 Location SW SE NE330 Ft. From S Line NE990 Ft. From E Line Quarter

1st. Report

Completion AUG 2 1950

Remarks

Spudding Date 6-17-50

Drlg. Data

10 3/4" @ 250 Lans. 1821 KC 2040B KC 2220 Cong. 2392 Hunton 2457DST 2458-67 Rec. salt water Maq. 2520Vioaa 2566 Br. dol. 2594 Simp. sd 2623Arb. 2758 Regan 3522 Granite 3572TD 3585 7" @ 2766 1000 AComp. for SWD Input 358 bw

J. E. TYRA