


Section 17 Township 23 Range 4E

Well No. #26 Scully

Company Phillips Oil Co.

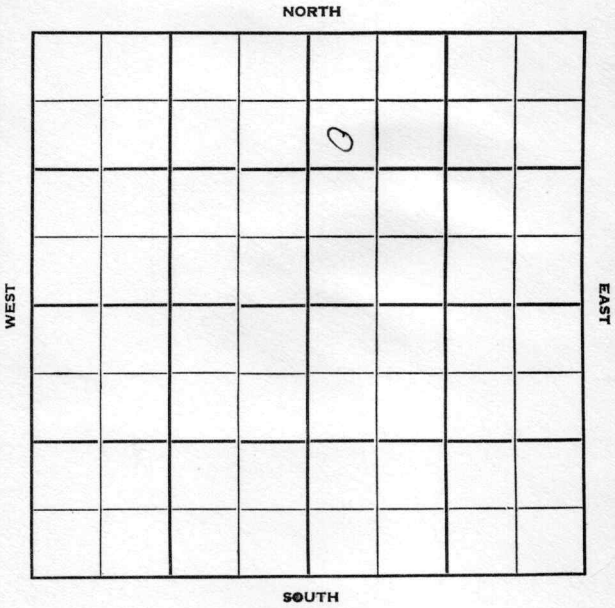


Sec. 17 Twp. 23 R. 4EWell No. #26 Scully FarmPhillips Oil Co. CompanyPhillips Contractor900 Ft. from N. Line

Ft. from S. Line

Ft. from E. Line

330 Ft. from W. Line

SW NW NE

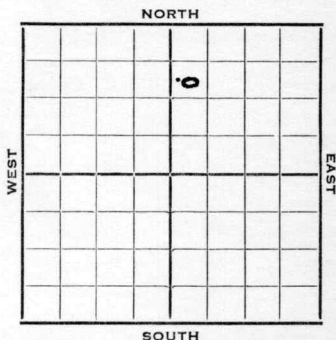

1952 Elev. 1382' REPORT

6/18 Spud 6-16-52

Drlg. 187

9/17 Spud 6-16-52

Oil well TD 2460' Lans. 1978'

B KC 2157' Marm. 2208' Kh. 2354'

Hunton 2371' Maq. 2427' Viola 2449'

TD 2455 7" @ 2449 DP to 2426 HFW

DD 2455 S/144 BW DD 2460'

S/23 BWPH SP 2440 40/2375-85

S/16 BO 140 BW S/7 BOPD 189 BW

P/55 BO 160 BWPD

Comp. 80 BOPD 2540 BW

COMPLETED

County **Butler** State **Kansas**

Sec. **17** (Blk. **23** (Sur. **4E** Map No.

Operator **Phillips Oil Co.**

Well No. **26** Farm **Scully**

Elev.	Location	SW	NW	NE
-------	----------	----	----	----

900 Ft. From **N** Line **NR**

330 Ft. From **W** Line Quarter

1st. Report JUN 1 9 1952

Completion	
------------	--

Remarks

Phillips - Contr.

Spudding Date **6-16-52**

Drbg. Data

Drlg. 187

J. G. McGEHEE

J. G. McGEHEE