


Butler

KANSAS

Section 17 Township 23 Range 4E

Well No. #1 Scully SWD

Company Phillips Petroleum Corporation

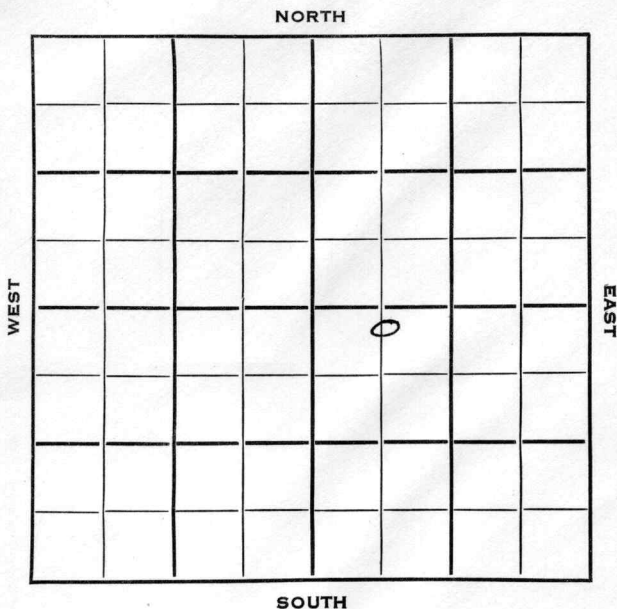

Butler

Sec. 17 Twp. 23 R. 4E **KANSAS**Well No. #1 Scully SWD FarmPhillips Petroleum Corporation Company

Contractor


Elbing Pool

463 Ft. from N. Line

Ft. from S. Line

705 Ft. from E. Line725 Ft. from W. Line

C N L NW SE

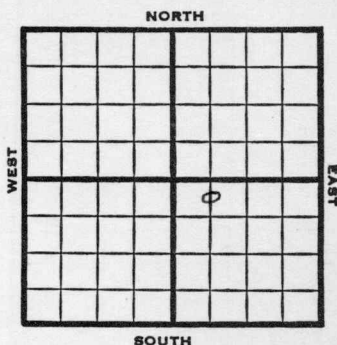

1953 Elev. 1369' REPORT

3/4 R U R

4/15 Spud 3-4-53

SWD Well

TD 3083

13" @ 218'

Hunton 2321, Viola 2409, Simp 2462,
Arb 2504SCHLUMBERGER TOPS: Lans 1733, Hunton
2327, Viola 2413, Simp 2463, Arb 2500,
Regan 3028, Quartsite 3064, PreCamb
3072,


TD 3083

7" @ 2510'

CO to 3083,

Comp. SWD well

ABANDONED

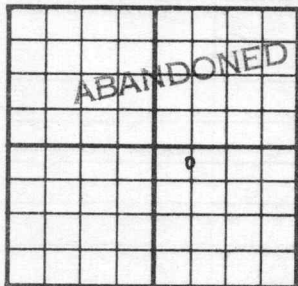County Butler State KansasSec. 17 (Blk.
Twps.) 23 (Sur.
Rge.) 4E Map No.Operator Phillips Pet.Well No. 1 Farm Scully SWDElev. 1369 Location C N L NW SE463 Ft. From N Line SE725 Ft. From W Line Quarter1st. ReportCompletion APR 15 1953Remarks Elbing PoolSpudding Date 3-4-53Drlg. Data SWD well TD 308313" @ 218 Hunton 2321 Viola 2409Simp. 2462 Arb. 2504 SCHLUMBERGER TOPSLans. 1733 Hunton 2327 Viola 2413Simp. 2463 Arb. 2500 Regan 3028Quartsite 3064 PreCamb. 3072 TD 30837" @ 2510 CO to 3083 Comp. SWD well