


Butler KANSAS

Section 17 Township 23 Range 4-E

Well No. #18 J. C. Scully

Company Phillips

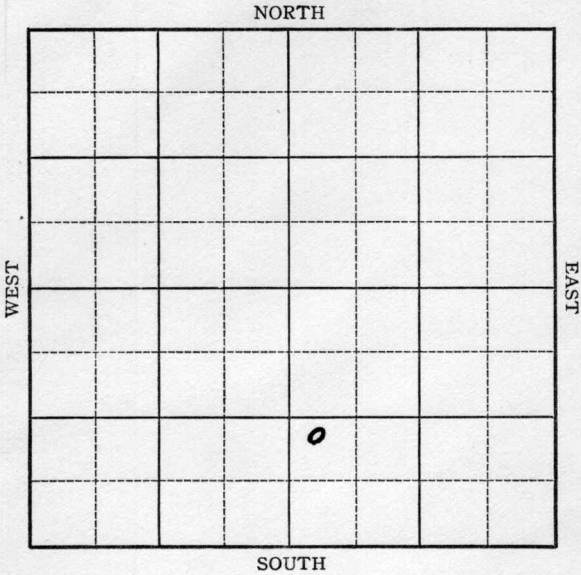

Butler KANSASMap No. 14 Sec. 17 Twp. 23 R. 4EWell No. 18 J. C. ScullyPhillips Company

Contractor

FIRST REPORT

SECTION PLAT

		0	

_____ Ft. from N. Line

1229 Ft. from S. Line

_____ Ft. from E. Line

288 Ft. from W. Line

Location _____

Rig up _____

Drilling and Remarks:

mch.

RECORD

Cased _____ in., _____ ft.

Sand _____

Gas _____

Oil _____

Total Depth _____

PRODUCTION

1st 24 hrs. Nat. _____

1st 24 hrs. after shot _____

Gas _____ Cu. Ft.

Dry Hole _____

Abandoned _____

Date

SEP 22 1937

19

H. D. Hatfield Scout

Butler

KANSAS

Map No. 14 Sec. 17 Twp. 23 R. 4EWell No. 18 J. C. ScullyPhillips Petroleum Company

Contractor

COMPLETED

NW SW SE

SECTION PLAT

		0	

 Ft. from N. Line1229 Ft. from S. Line Ft. from E. Line288 Ft. from W. LineLocation Rig up

Drilling and Remarks:

2000 acidProd. 96 oil
69 water

RECORD

Cased 7 in., 2028 ft.Sand KC 1940Gas Oil Total Depth 2080

PRODUCTION

1st 24 hrs. Nat. 1st 24 hrs. after shot Gas Cu. Ft.Dry Hole Abandoned

Date

OCT 27 1937

19

H. D. Hatfield

Scout