
Form 51 5M 2-22 8411

Kansas

Map No. _____ Sec. 22 Twp. 23 R. 13

Well No. 8 Shambaugh Farm

Ralco Oil Company

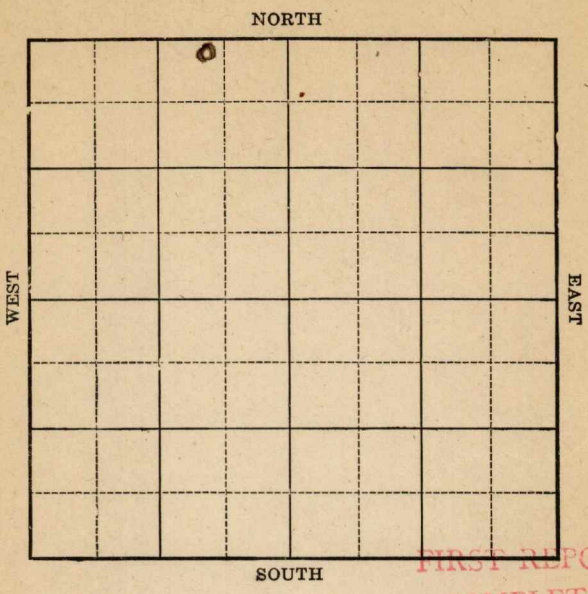

FIRST REPORT COMPLETED

Location _____

Drilling Remarks:

Rig Up _____

Drilling Remarks:

RECORD

Cased _____ in. _____ ft.

Sand _____

Gas _____

Oil _____

Total Depth _____

PRODUCTION

1st 24 hrs. Nat. _____

1st 24 hrs. after shot _____

Gas _____ cu. ft.

Dry Hole _____

Abandoned _____

Form 252A 5M 4-22 8765

Map No. _____ Sec. 22 Twp. 23 R. 13

Well No. #8 Shambaugh Farm


Galco Oil Company

200 Ft. from N. Line

_____ Ft. from S. Line

760 Ft. from E. Line

_____ Ft. from W. Line

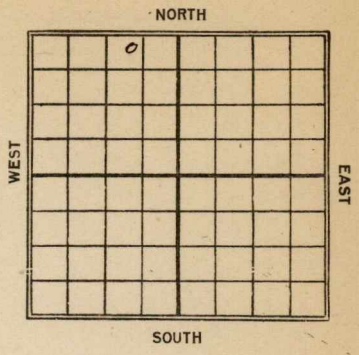

Date 1922	REPORT
8/13	Rgn up
9/16	Sand 1597-1683 - Shot 90 qts. Est. 200 Bbls.

Form 26—1M—4-19—Mid-West

Map No. Kans 17 Sec. 22 Twp. 23 R. 13

Well No. 8 Shamrock

Kalas Oil Company

Contractor

FIRST REPORT


200' Ft. from N. Line

Ft. from S. Line

760' Ft. from E. Line

Ft. from W. Line

SECTION PLAT

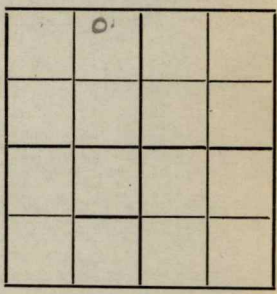

Location

Rig up

Drilling and Remarks:

R. O. S.

8/9 Rigg up

RECORD

Cased in., ft.

Sand

Gas

Oil

Total Depth

PRODUCTION

1st 24 hrs. Nat.

1st 24 hrs. after shot

Gas Cu. Ft.

Dry Hole

Abandoned

Date

AUG 1 2 1929 191

M. A. BENEAR Scout

Form 26—1M—4-19—Mid-West

Map No. KANSAS 17 Sec. 22 Twp. 23 R. 13


Well No. 8 Shamburgh

Kalas Company

Contractor

COMPLETED

SECTION PLAT

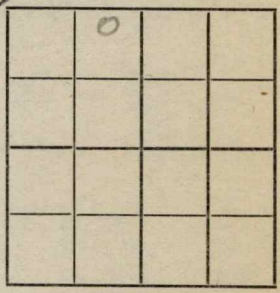

200 Ft. from N. Line

Ft. from S. Line

760 Ft. from E. Line

Ft. from W. Line

Location

Rig up

Drilling and Remarks:

shot 90 qts

est. 200 bbls

RECORD

Cased in., ft.

Sand

Gas

Oil 1597-1673

Total Depth 1673

PRODUCTION

1st 24 hrs. Nat.

1st 24 hrs. after shot

Gas Cu. Ft.

Dry Hole

Abandoned

Date

SEP 16 1922

191

M. A. BENEAR

Scout