


Section 17 Township 23 Range 4EWell No. #25 ScullyCompany Phillips Pet.

NORTH

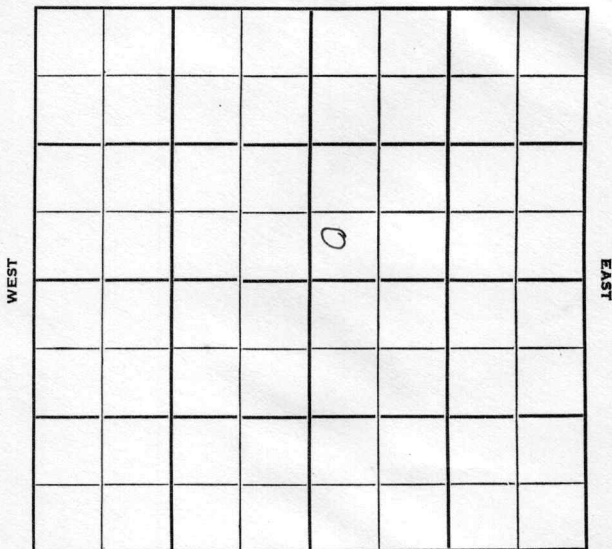

SOUTH

Butler

KANSAS



Sec. 17 Twp. 23 R. 4E

Well No. #25 Scully Farm

Phillips Pet. Company

Contractor


Ft. from N. Line

418' Ft. from S. Line

Ft. from E. Line

200' Ft. from W. Line

SW SW NE

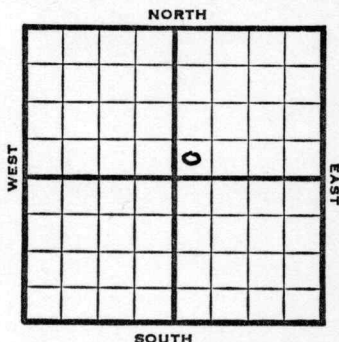

1952

Elev. 1371'

REPORT

6/25

Location

9/17

Spud 6-26-52

Oil well TD 2319' 10" @ 195

KC 1940' B KC 2100' Marm. 2167'

Hunton 2305' TD 2314' 7" @ 2306

DD 2319 B/4½ BO 6¼ hr.

500 A S/132 BO 13¼ hr. S/20 BO

2 hr. P/66 BO 144 BWPD P/60 BO

150 BWPD

Comp. 36 BOPD 132 BW

COMPLETED

County **Butler** State **Kansas**Sec. **17** (Blk. Twp.) **23** (Sur. Rge.) **4E** Map No.Operator **Phillips Pet.**Well No. **25** Farm **Scully**Elev. Location **SW SW NE****418** Ft. From **S** Line **NE****200** Ft. From **W** Line Quarter1st. Report **JUN 25 1952**

Completion


Remarks

Spudding Date

Drlg. Data

Location**J. G. McGEHEE**

County Butler State Kansas
 Sec. 17 (Blk.
Twp.) 23 (Sur.
Rge.) 4E Map No.
 Operator Phillips Pet.
 Well No. 25 Farm Scully
 Elev. 1371 Location SW SWNE

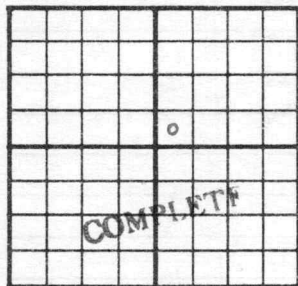

418 Ft. From S Line NE
200 Ft. From W Line Quarter
 1st. Report
 Completion SEP 17 1952
 Remarks

Spudding Date 6-26-52

Drlg. Data Oil well TD 2319

10" @ 195 KC 1940 B KC 2100

Marm. 2167 Hunton 2305 TD 2314

7" @ 2306 DD 2319 B/ $4\frac{1}{2}$ bo $6\frac{1}{4}$ hr.

500 A S/ 132 bo $13\frac{1}{4}$ hr. S/ 20 bo 2 hr.

P/ 66 bo 144 bwpd P/ 60 bo 150 bwpd

Comp. 36 bopd 132 bw

J. G. McGEHEE