


Section 17 Township 23 Range 4E

Well No. #10-A Scully

Company Phillips Petroleum Corporation

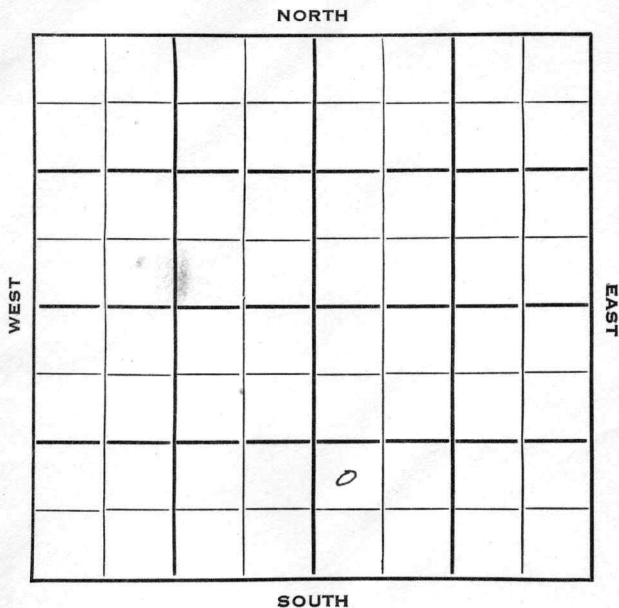

Butler

KANSAS



Sec. 17 Twp. 23 R. 4E

Well No. #10-A Scully Farm

Phillips Petr. Company

Phillips Contractor


Elbing Pool

1495 Ft. from N. Line

_____ Ft. from S. Line

_____ Ft. from E. Line

330 Ft. from W. Line

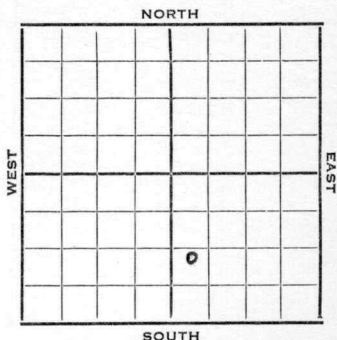


NW SW SE

1953 Elev. 1365' REPORT

2/25 Spud 2-22-53
10" @ 222
Drlg. 777

4/8 Spud 2-22-53
Oil well TD 2378 10" @ 222
Lans. 1726 KC 1946 B KC 2120
Marm. 2167 Kh. 2304 Hunton 2337
TD 2342 7" @ 2341 DD 2361
S/5 BO 155 BW 5 hrs. DD 2367
S/4½ BO 235 BW 6 hrs. DD 2378
S/1¼ BO 56 BWPH
Comp. 200 BOPD 8841 BW

COMPLETED

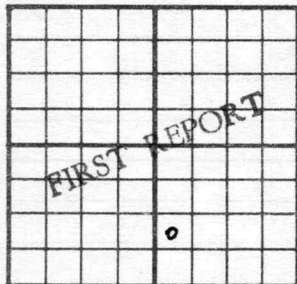
County Butler State KansasSec. 17 (Blk.) 23 (Sur.) 4E Map No.Operator Phillips Pet.Well No. 10-A farm ScullyElev. Location NW SW SE1495 Ft. From N Line SE330 Ft. From W Line Quarter1st. Report FEB 25 1953

Completion

Remarks

Phillips - Contr.Spudding Date 2-22-53Drlg. Data Elbing Pool10" @ 222 drlg. 777

County Butler State Kansas
 Sec. 17 (Blk.) 23 (Sur.) 4E Map No.
 Operator Phillips Pet.
 Well No. 10-A Farm Scully
 Elev. 1365 Location NW SW SE

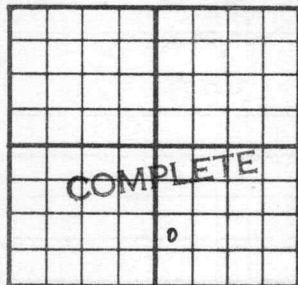

1495 Ft. From N Line SE
330 Ft. From W Line Quarter

1st. Report

Completion APR 8 1953

Remarks Elbing Pool

Phillips - Contr.

Spudding Date 2-22-53

Drlg. Data Oil well TD 2378

10" @ 222 Lans. 1726 KC 1946

B KC 2120 Marm. 2167 Kh. 2304

Hunton 2337 TD 2342 7" @ 2341

DD 2361 S/ 5 bo 155 bw 5 hr.

DD 2367 S/ $4\frac{1}{2}$ bo 235 bw 6 hr.

DD 2378 S/ $1\frac{1}{4}$ bo 56 bwph

Comp. 200 bopd 8841 bw

J. G. McGEHEE