


Butler

KANSAS
4E

Section 17 Township 23 Range 4E

Well No. #19 J. C. Scully

Company Phillips Pet.

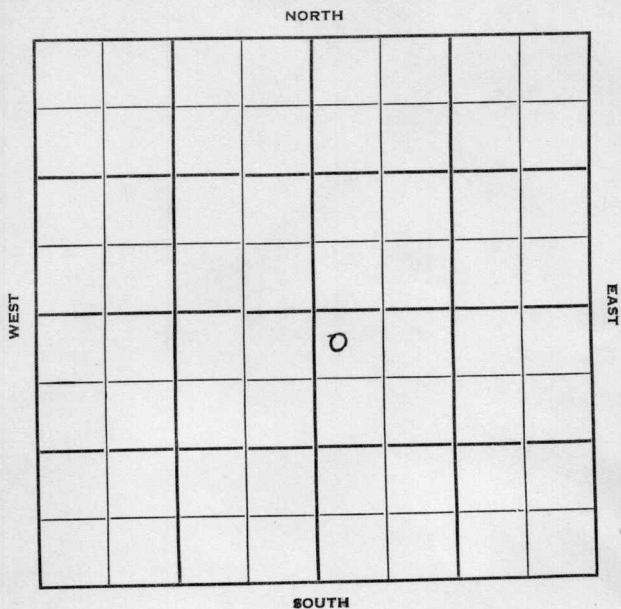

Sec. _____ Twp. _____ R. _____

#19 J. C. Scully

Well No. _____ Farm _____

Phillips Pet.

Company _____

Miscellaneous

Contractor _____

330'

Ft. from N. Line


Ft. from S. Line

Ft. from E. Line

221'

Ft. from W. Line

NE NW SE

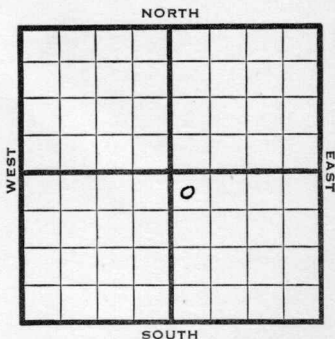

1950

Elev 1367

REPORT

4/26

Drlg. 105'

5/31

10" @ 213

Kinderhook 2288

Hunton 2325

Maz 2386

Viola 2406

DST 2406-15

TD 2510

rec 1100' oil

Simp 2436

DST 2418-26 opn 20 min

rec 2190' oil

DST 2436-40 opn 30 min

rec 45' mud

Arb 2496

TD 2510

5" @ 2498

4/2434-35

swab 6½ bo 20 min

11 bo 30 min

56/2420-34

swab 57 bo 30 min

34/2407-15 HFO

comp 100 bopd no wtr

COMPLETED

Map No. _____ Sec. 17 Twp. 23 R. 4EWell No. 19 J. C. ScullyPhillips Pet.

Company _____

Contractor _____

NW NW SE

SECTION PLAT

330 Ft. from N. Line

_____ Ft. from S. Line

_____ Ft. from E. Line

221 Ft. from W. LineButler County

Location _____

Rig up _____

Drilling and Remarks:

drlg. 105

RECORD

Cased _____ in., _____ ft.

Sand _____

Gas _____

Oil _____

Total Depth _____

PRODUCTION

1st 24 hrs. Nat. _____

1st 24 hrs. after shot _____

Gas _____ Cu. Ft.

Dry Hole _____

Abandoned _____

Date

APR 26 1900 19J. E. TYRA Scout

Form 26 200 Bks. 11-49 Petrol KansasMap No. _____ Sec. 17 Twp. 23 R. 4EWell No. 19 J. C. ScullyPhillips Pet. _____ Company_____ Contractor
NW NW SE E1.1367

SECTION PLAT

330 Ft. from N. Line

_____ Ft. from S. Line

_____ Ft. from E. Line

321 Ft. from W. LineButler

Location _____

Rig up _____

Drilling and Remarks:

10" C 213Kinderhook 2288Hernton 2325Mag. 2386Viola 2406DST 2406-15Rec. 1100' oil

RECORD

Cased _____ in., _____ ft.

Sand _____

Gas _____

Oil _____

Total Depth 2510

PRODUCTION

1st 24 hrs. Nat. _____

1st 24 hrs. after shot _____

Gas _____ Cu. Ft.

Dry Hole _____

Abandoned _____

Date

MAY 31 1950

19

J. E. TYRA Scout

OVER

Simp 2436

DST 2418-26

Rec. 2190' oil

DST 2436-40

Rec. 45' mud

arb. 2496

T.D. 2510

5" c 2498

4/ 2434-35

Swab 6 1/2 ba 20 min

" 11 ba 30 min

56/ 2420-34

swab 57 ba 30 min.

34/ 2407-15 H70

Comp. 100 bpd no water

Scout Cards
Land Small Map
Land Wall Map
Tracings
France Map
Index Map
Index

NH

SECTION 1641

Collector

Company

Map No

Map No

Sec

Twp

R