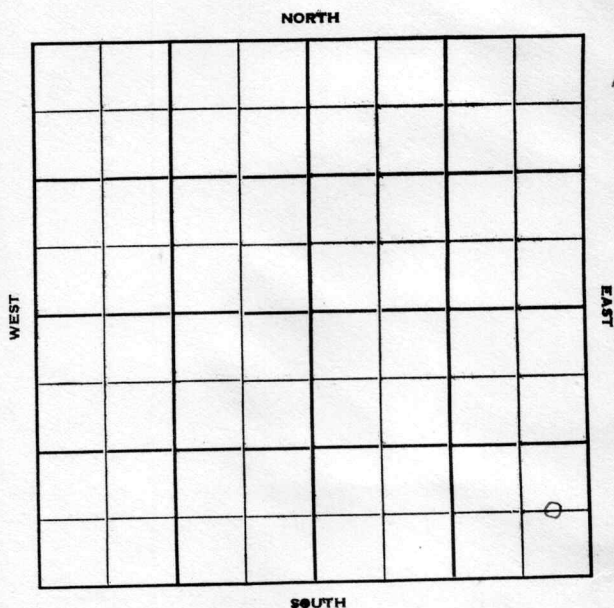


Section 7 Township 23 Range 4EWell No. #2 LathropCompany Val Jean Oil

Butler

KANSAS

Sec. 7 Twp. 23 R. 1E

Well No. #2 Lathrop Farm

Val Jean Oil Company

H. J. Uhl Contractor


1320 Ft. from N. Line

_____ Ft. from S. Line

330 Ft. from E. Line

_____ Ft. from W. Line

C E/2 E/2 SE

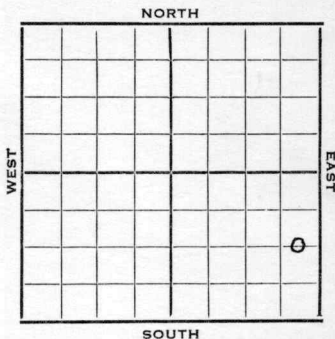

1952

Elev. 1378'

REPORT

2/27

Spud 2-20-52

8" @ 90'

Drlg. 1308'

4/2

Spud 2-20-52

Oil Well TD 2427

8" @ 90'

Hunton 2414 TD 2414

4" 2412 DD 2418 SO& wtr.


DD 2420 10 GO 20 GW 300 A

HFW DD 2427 oil inc.

Comp. 30 bopd

COMPLETED

County **Butler** State **Kansas**
Sec. **7** (Blk.) **23** (Sur.) **4E** Map No.
Operator **Val Jean Oil**
Well No. **2** Farm **Lathrop**
Elev. Location **C E/2 E/2 SE**

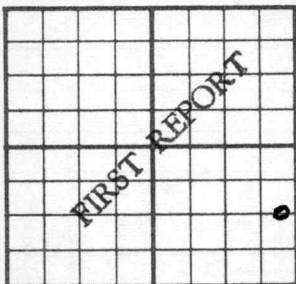

1320 Ft. From **N** Line **SE**

330 Ft. From **E** Line Quarter

1st. Report **FEB 27 1952**

Completion

Remarks

H. J. Uhl - Contr.

Spudding Date **2-20-52**

Drlg. Data

8" @ 90 Drlg. 1308


J. G. McGEHEE

County Butler State Kansas
 Sec. 7 (Blk. Twp.) 23 (Sur. Rge.) 4E Map No.

Operator Val Jean Oil

Well No. 2 Farm Lathrop

Elev. 1378 Location C E/2 E/2 SE

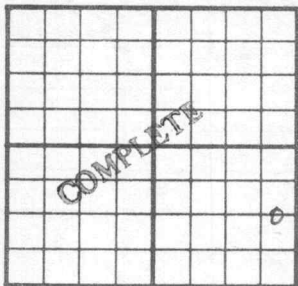

1320 Ft. From N Line SE

330 Ft. From E Line Quarter

1st. Report

Completion APR 2 1952

Remarks

H. J. Uhl - Contr.

Spudding Date 2-20-52

Drlg. Data Oil well TD 2427

8" @ 90 Hunton 2414 TD 2414 4" @ 2412

DD 2418 SO & water DD 2420 10 go

20 gw 300 A HFW DD 2427 oil inc.

Comp. 30 bopd

J. G. McGEHEE