


Map No. _____ Sec. 1 Twp. 26 R. 4
 Well No. 3, Abraham Farm _____
Empire Company _____

NORTH

WEST

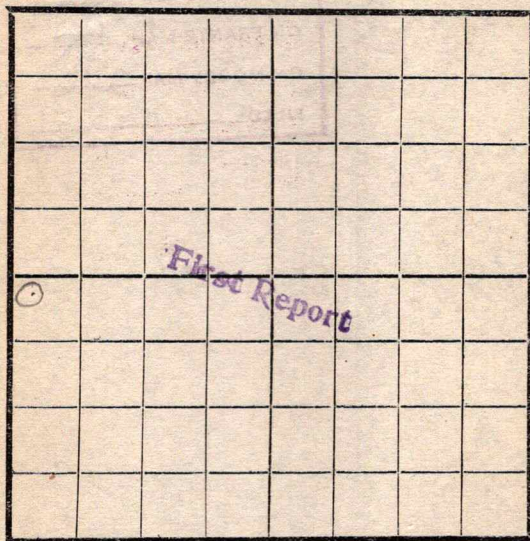

EAST

SOUTH

Location _____

Rig Up ☒ _____

Drilling and remarks _____

RECORD

Cased _____ in. _____ Ft.

Sand _____

Gas _____

Oil _____

Total Depth _____

PRODUCTION

1st 24 hrs. Nat. _____

1st 24 hrs. after shot _____

Gas _____ Cu. Ft.

Dry Hole _____

Abandoned _____

Date


8-29, 1917 Lautz Scout

Map No. _____ Sec. 1 Twp. 26 R. 4
 Well No. 3 Abraham Farm _____
Engine Company _____

NORTH

WEST

EAST

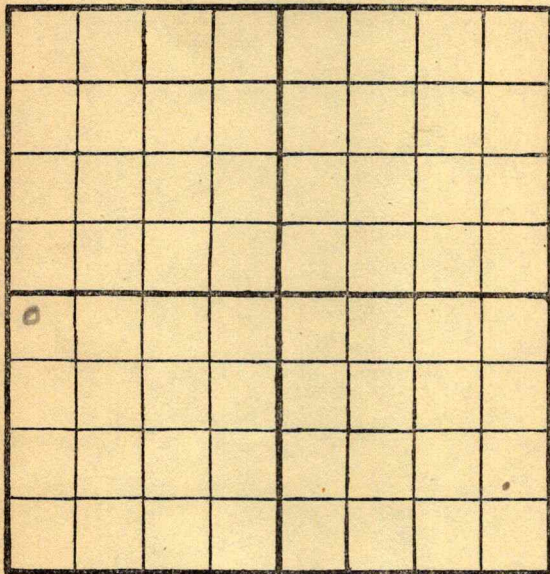

SOUTH

Location _____

Rig Up _____

Drilling and remarks

960

RECORD

Cased _____ in. _____ Ft.

Sand _____

Gas _____

Oil _____

Total Depth _____

PRODUCTION

1st 24 hrs. Nat. _____

1st 24 hrs. after shot _____

Gas _____ Cu. Ft.

Dry Hole _____

Abandoned _____

Date


10/9, 1917,

Conrad J Scout

Map No. _____ Sec. 1 Twp. 26 R. 4
 Well No. 3 Abraham Farm _____
Empire Company _____

NORTH

WEST

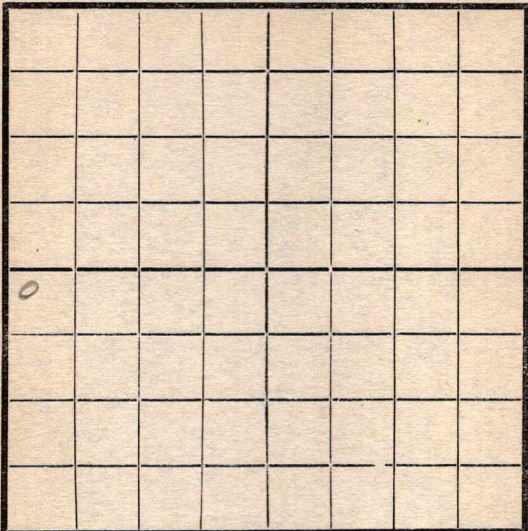

EAST

SOUTH

Location _____
 Rig Up _____
 Drilling and remarks _____

*Shut down
 for water
 960*

RECORD

Cased _____ in. _____ Ft.
 Sand _____
 Gas _____
 Oil _____
 Total Depth _____

PRODUCTION

1st 24 hrs. Nat. _____
 1st 24 hrs. after shot _____
 Gas _____ Cu. Ft.
 Dry Hole _____
 Abandoned _____

Date _____

10/17, 1912 C. Smith Scout

Map No. _____ Sec. 1 Twp. 26 R. 4Well No. 3 Abraham Farm _____Company Empire

NORTH

WEST

EAST

SOUTH

Location _____

Rig Up _____

Drilling and remarks

Shut Down960

RECORD

Cased _____ in. _____ Ft.

Sand _____

Gas _____

Oil _____

Total Depth _____

PRODUCTION

1st 24 hrs. Nat. _____

1st 24 hrs. after shot _____

Gas _____ Cu. Ft.

Dry Hole _____

Abandoned _____

Date

10/24, 1917 Empire Scout

Map No. _____ Sec. 1 Twp. 26 R. 4Well No. 3 Abraham
Engine _____ Compan _____

NORTH

WEST

EAST

SOUTH

Location ✓

Rig up _____

Drilling and Remarks:

FIRST REPORT**RECORD**

Cased _____ in., _____ ft.

Sand _____

Gas _____

Oil _____

Total Depth _____

PRODUCTION

1st 24 hrs. Nat. _____

1st 24 hrs. after shot _____

Gas _____ Cu. Ft.

Dry Hole _____

Abandoned _____


Date

10/31 191 2 Condy Scout

Map No. _____ Sec. 1 Twp. 26 R. 4
 Well No. 3 Abraham Farm _____
Engine Company _____

NORTH

WEST

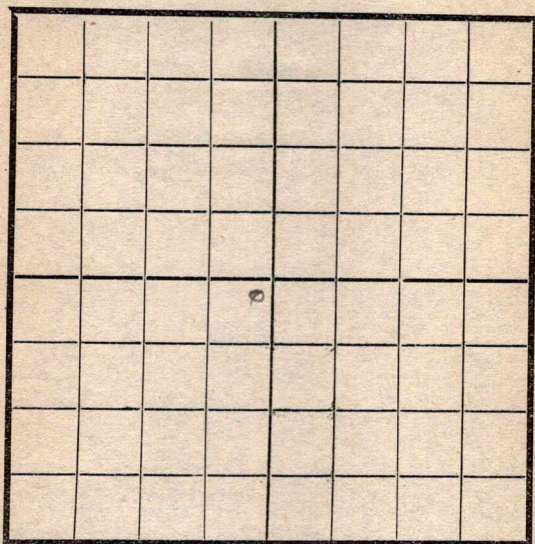

EAST

SOUTH

Location _____
 Rig Up ☒ _____
 Drilling and remarks _____

RECORD

Cased _____ in. _____ Ft.
 Sand _____
 Gas _____
 Oil _____
 Total Depth _____

PRODUCTION

1st 24 hrs. Nat. _____
 1st 24 hrs. after shot _____
 Gas _____ Cu. Ft.
 Dry Hole _____
 Abandoned _____


Date

11-7, 1917 Cardiff Scout

Map No. _____ Sec. 1 Twp. 26 R. 4
 Well No. 3 Abraham Farm _____
Engine Company _____

NORTH

WEST

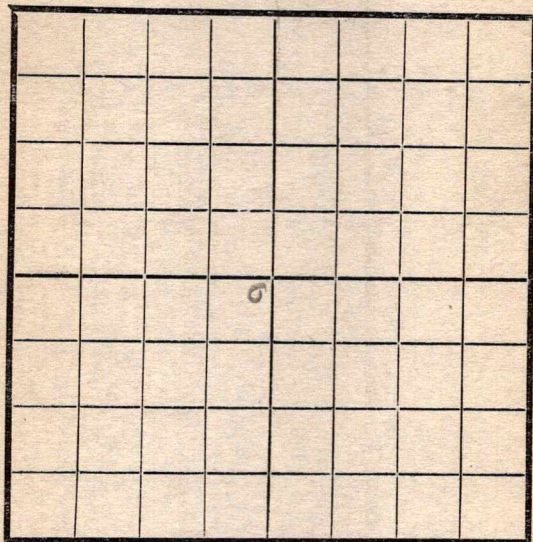

EAST

SOUTH

Location _____
 Rig Up ☒ _____
 Drilling and remarks _____

RECORD

Cased _____ in. _____ Ft.
 Sand _____
 Gas _____
 Oil _____
 Total Depth _____

PRODUCTION

1st 24 hrs. Nat. _____
 1st 24 hrs. after shot _____
 Gas _____ Cu. Ft.
 Dry Hole _____
 Abandoned _____


Date

11/14, 1917 Cardiff Scout

Map No. _____ Sec. 1 Twp. 26 R. 4
 Well No. 3 Abraham Farm _____
Engine Company _____

NORTH

WEST

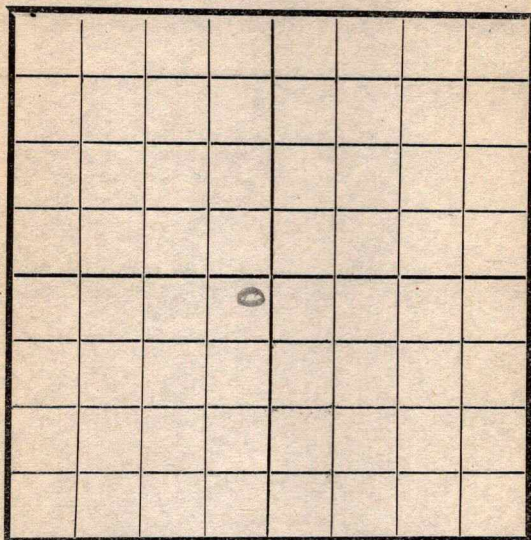

EAST

SOUTH

Location _____
 Rig Up ☒ _____
 Drilling and remarks _____

RECORD

Cased _____ in. _____ Ft.
 Sand _____
 Gas _____
 Oil _____
 Total Depth _____

PRODUCTION


1st 24 hrs. Nat. _____
 1st 24 hrs. after shot _____
 Gas _____ Cu. Ft.
 Dry Hole _____
 Abandoned _____

Date _____
11/21, 1917 Carley Scout

Map No. _____ Sec. 1 Twp. 26 R. 4Well No. 3 Ralston _____ Farm __________
Empire Company

NORTH

WEST

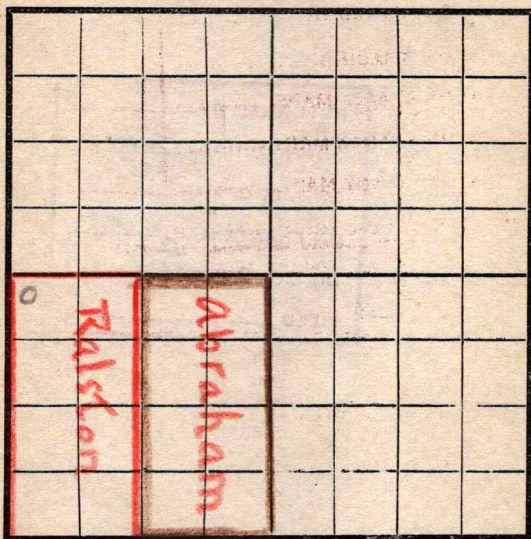

EAST

SOUTH

Location _____

Rig Up _____

Drilling and remarks

LD 960

(Notes—Empire has made a division of the S.W. q. The West 80 acres is known as the Ralston farm and East 80 the Abraham farm)

RECORD

Cased _____ in. _____ Ft.

Sand _____

Gas _____

Oil _____

Total Depth _____

PRODUCTION

1st 24 hrs. Nat. _____

1st 24 hrs. after shot _____

Gas _____ Cu. Ft.

Dry Hole _____

Abandoned _____


Date

10/31, 1917 Candiff _____ Scout _____

Map No. _____ Sec. 1 Twp. 26 R. 4
 Well No. 3 Ralston Farm _____
Engine Company _____

NORTH

WEST

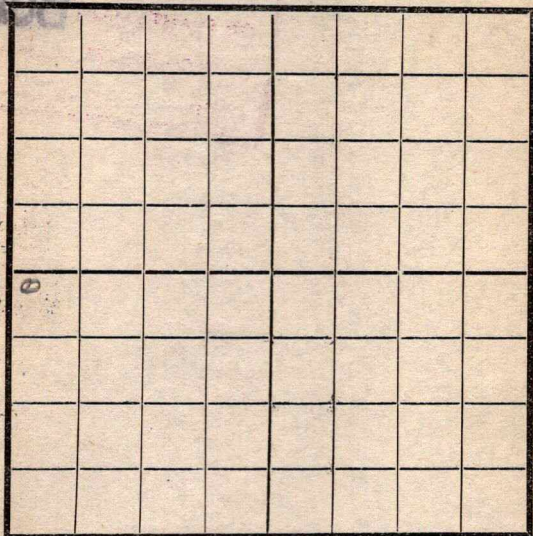

EAST

SOUTH

Location _____

Rig Up _____

Drilling and remarks

1075

RECORD

Cased _____ in _____ Ft.

Sand _____

Gas _____

Oil _____

Total Depth _____

PRODUCTION

1st 24 hrs. Nat. _____

1st 24 hrs. after shot _____

Gas _____ Cu. Ft.

Dry Hole _____

Abandoned _____

Date


11-7, 1912 Cordell Scout _____

Map No. _____ Sec. 1 Twp. 26 R. 4
 Well No. 3 Rolston Farm _____
Empire Company _____

NORTH

WEST

EAST

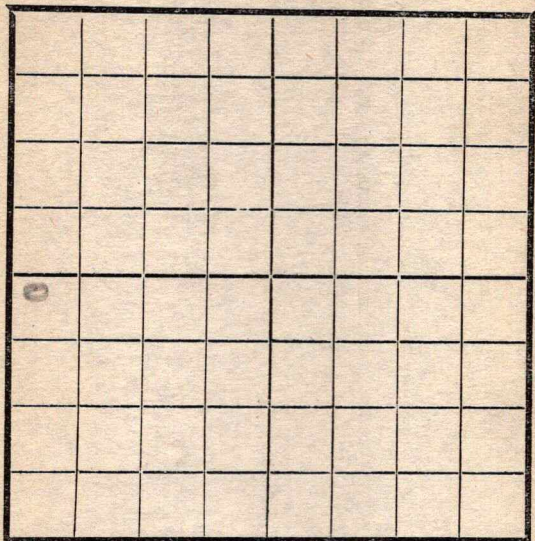

SOUTH

Location _____
 Rig Up _____
 Drilling and remarks _____

1280

RECORD

Cased _____ in. _____ Ft.
 Sand _____
 Gas _____
 Oil _____
 Total Depth _____

PRODUCTION


1st 24 hrs. Nat. _____
 1st 24 hrs. after shot _____
 Gas _____ Cu. Ft.
 Dry Hole _____
 Abandoned _____

Date 11/14, 1917 Empire Scout _____

Map No. _____ Sec. 1 Twp. 26 R. 4
 Well No. 3 Ralston Farm _____
Engine Company _____

NORTH

WEST

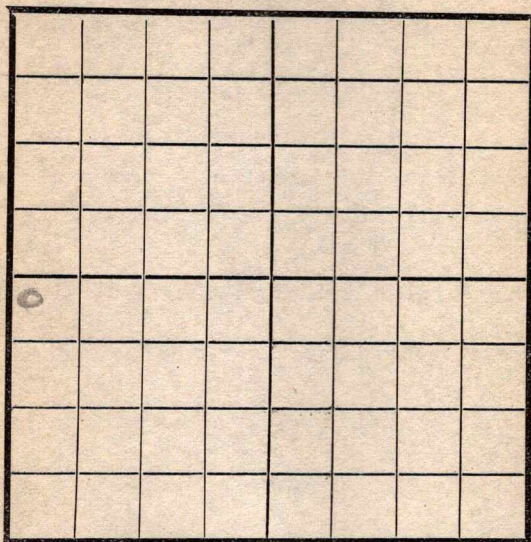

EAST

SOUTH

Location _____
 Rig Up ✓ _____
 Drilling and remarks _____

Shut Down
1280

RECORD

Cased _____ in. _____ Ft.
 Sand _____
 Gas _____
 Oil _____
 Total Depth _____

PRODUCTION


1st 24 hrs. Nat. _____
 1st 24 hrs. after shot _____
 Gas _____ Cu. Ft.
 Dry Hole _____
 Abandoned _____

Date _____
4/21, 1917 7 Engineering Scout

Map No. _____ Sec. 1 Twp. 26 R. 4
 Well No. 3 Ralston Farm _____
 _____ Company

NORTH

WEST

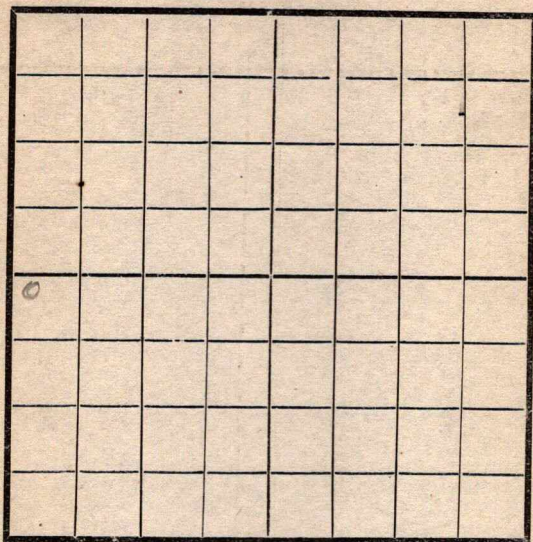

EAST

SOUTH

Location _____
 Rig Up _____
 Drilling and remarks

16 10

RECORD

Cased _____ in. _____ Ft.
 Sand _____
 Gas _____
 Oil _____
 Total Depth _____

PRODUCTION


1st 24 hrs. Nat. _____
 1st 24 hrs. after shot _____
 Gas _____ Cu. Ft.
 Dry Hole _____
 Abandoned _____

Date

11/28, 1912 Condiff Scout

Map No. _____ Sec. 1 Twp. 26 R. 4
 Well No. 3 Ralston Farm _____
Engine Company _____

NORTH

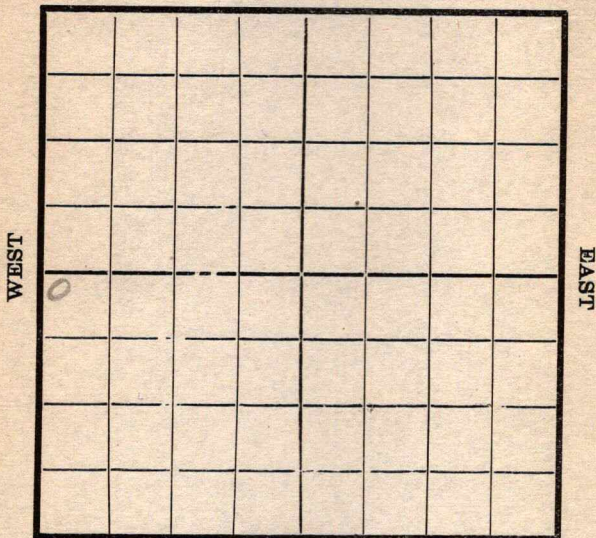

SOUTH

Location _____
 Rig Up _____
 Drilling and remarks

1750

RECORD

Cased _____ in. _____ Ft.
 Sand _____
 Gas _____
 Oil _____
 Total Depth _____

PRODUCTION


1st 24 hrs. Nat. _____
 1st 24 hrs. after shot _____
 Gas _____ Cu. Ft.
 Dry Hole _____
 Abandoned _____

Date 1915, 1917 Conley Scout

Map No. _____ Sec. 1 Twp. 26 R. 4Well No. 3 Rolston Farm _____
Engine Company _____

NORTH

WEST

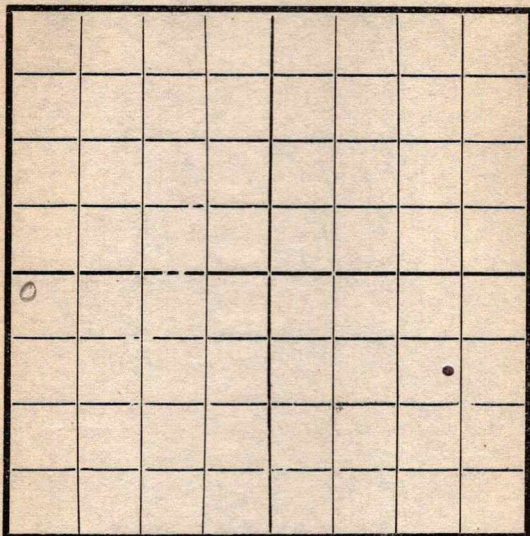

SOUTH

Location _____

Rig Up _____

Drilling and remarks

SD 1750

RECORD

Cased _____ in. _____ Ft.

Sand _____

Gas _____

Oil _____

Total Depth _____

PRODUCTION

1st 24 hrs. Nat. _____

1st 24 hrs. after shot _____

Gas _____ Cu. Ft.

Dry Hole _____

Abandoned _____


Date

1/2, 1918 Candry Scout

Map No. _____ Sec. 1 Twp. 26 R. 4
 Well No. 3 Ralston Farm _____
Emery Company

NORTH

WEST

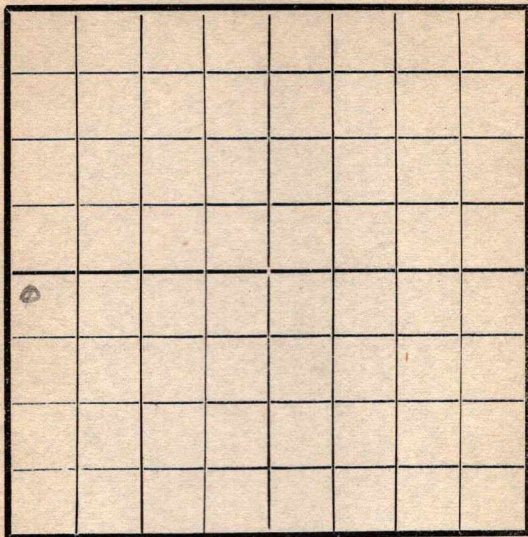

EAST

SOUTH

Location _____
 Rig Up _____
 Drilling and remarks

22
1980

RECORD

Cased _____ in. _____ Ft.
 Sand _____
 Gas _____
 Oil _____
 Total Depth _____

PRODUCTION

1st 24 hrs. Nat. _____
 1st 24 hrs. after shot _____
 Gas _____ Cu. Ft.
 Dry Hole _____
 Abandoned _____


Date

1/16, 191 Scout Scout

Map No. _____ Sec. 1 Twp. 26 R. 4Well No. 3 Ralston Farm _____Empire 898 Company _____

NORTH

WEST

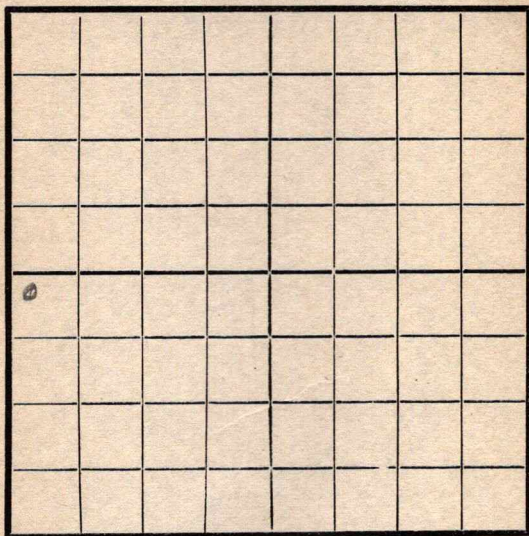

EAST

SOUTH

Location _____

Rig Up _____

Drilling and remarks

2080

RECORD

Cased _____ in. _____ Ft.

Sand _____

Gas _____

Oil _____

Total Depth _____

PRODUCTION

1st 24 hrs. Nat. _____

1st 24 hrs. after shot _____

Gas _____ Cu. Ft.

Dry Hole _____

Abandoned _____

Date


1/23, 1918 Candy Scout _____

Map No. _____ Sec. 1 Twp. 26 R. 4
Well No. 3 Palstan Farm _____
Pumpkin Company _____

NORTH

WEST

EAST

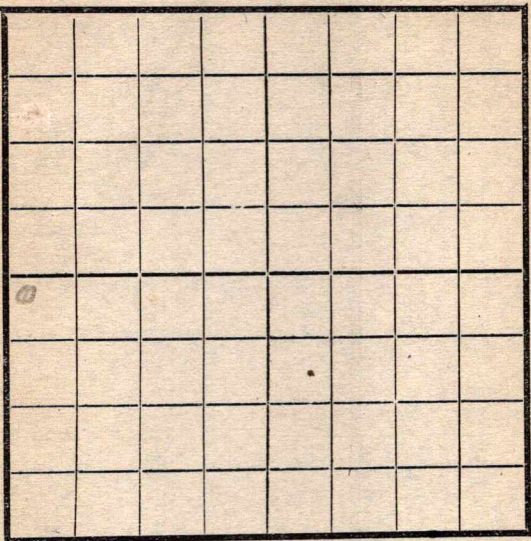

SOUTH


	RECORD
Location _____	Cased _____ in. _____ Ft.
Rig Up _____	Sand _____
Drilling and remarks	Gas _____
<u>2225</u>	Oil _____
	Total Depth _____
	PRODUCTION
	1st 24 hrs. Nat. _____
	1st 24 hrs. after shot _____
	Gas _____ Cu. Ft.
	Dry Hole _____
	Abandoned _____

Date 1/30, 1918 Candiff Scout

Map No. _____ Sec. 1 Twp. 26 R. 4Well No. 3 Ralston Farm _____Engine Company _____

NORTH

WEST

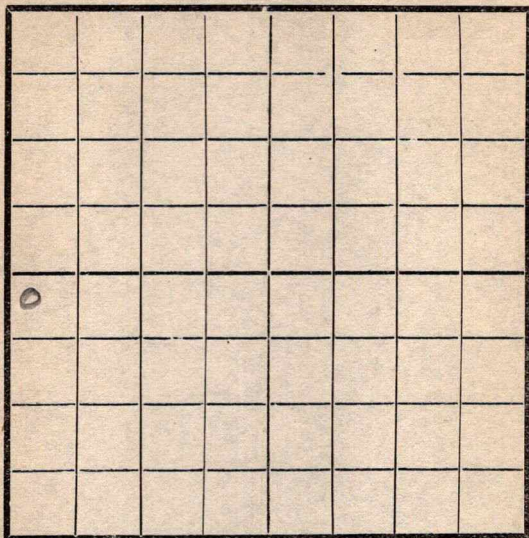

EAST

SOUTH

Location _____

Rig Up _____

Drilling and remarks

22
2225

RECORD

Cased _____ in. _____ F

Sand _____

Gas _____

Oil _____

Total Depth _____

PRODUCTION

1st 24 hrs. Nat. _____

1st 24 hrs. after shot _____

Gas _____ Cu. F

Dry Hole _____

Abandoned _____


Date

7/6, 1911 Scindia Scout _____

Map No. _____ Sec. 1 Twp. 26 R. 4Well No. 3 Ralston Farm __________Engine Company _____

NORTH

WEST

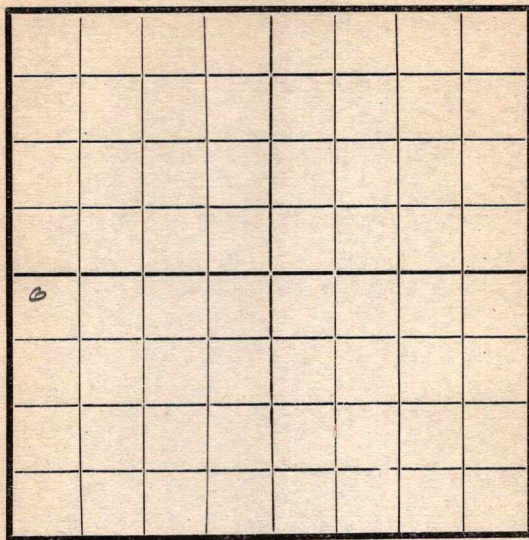

EAST

SOUTH

Location _____

Rig Up _____

Drilling and remarks

2340

RECORD

Cased _____ in. _____ Ft.

Sand _____

Gas _____

Oil _____

Total Depth _____

PRODUCTION

1st 24 hrs. Nat. _____

1st 24 hrs. after shot _____

Gas _____ Cu. Ft.

Dry Hole _____

Abandoned _____

Date

7/13, 1918 Endy Scout _____

Map No. _____ Sec. 1 Twp. 26 R. 4Well No. 3 Ralston Farm_____Cummins Company

NORTH

WEST

EAST

SOUTH

Location _____

Rig Up _____

Drilling and remarks

Top sound
2375

RECORD

Cased _____ in. _____ Ft.

Sand _____

Gas _____

Oil _____

Total Depth _____

PRODUCTION

1st 24 hrs. Nat. _____

1st 24 hrs. after shot _____

Gas _____ Cu. Ft.

Dry Hole _____

Abandoned _____

Date

2/25/8 1918 Cummins Scout

Map No. _____ Sec. 1 Twp. 26 R. 4

Well No. 3 Ralston Farm

Engine Company

NORTH

WEST

EAST

SOUTH

Location _____

Rig Up _____

Drilling and remarks

SD on top
2375

RECORD

Cased _____ in. _____ Ft.

Sand _____

Gas _____

Oil _____

Total Depth _____

PRODUCTION

1st 24 hrs. Nat. _____

1st 24 hrs. after shot _____

Gas _____ Cu. Ft.

Dry Hole _____

Abandoned _____


Date

2/27, 1911
S. Conley Scout

Map No. _____ Sec. 1 Twp. 26 R. 4Well No. 31 Ralston Farm __________Engine Company _____

NORTH

WEST

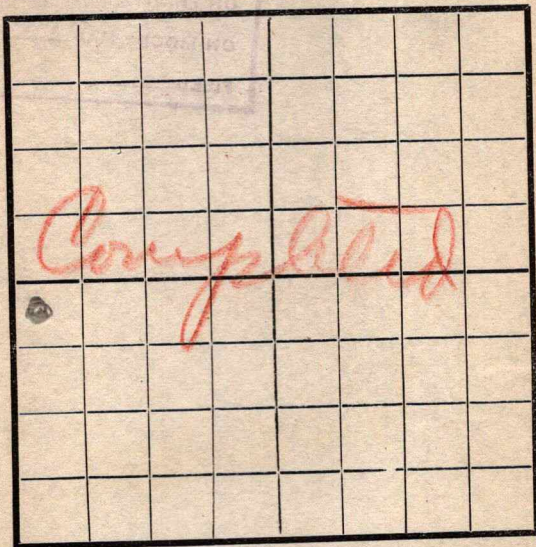

EAST

SOUTH

Location _____

Rig Up _____

Drilling and remarks

Est at400Bhe

RECORD

Cased _____ in. _____ Ft.

Sand 2377-2428

Gas _____

Oil _____

Total Depth _____

PRODUCTION

1st 24 hrs. Nat. _____

1st 24 hrs. after shot _____

Gas _____ Cu. Ft.

Dry Hole _____

Abandoned _____

Date

5/6

, 191

8 Conley

Scout _____